


Form 51-5M-4-27-21425

Map No. _____ Sec. 14 Twp. 32 R. 2E

Well No. 5 Buffington Farm

La Roche Oil & Gas Company

NORTH

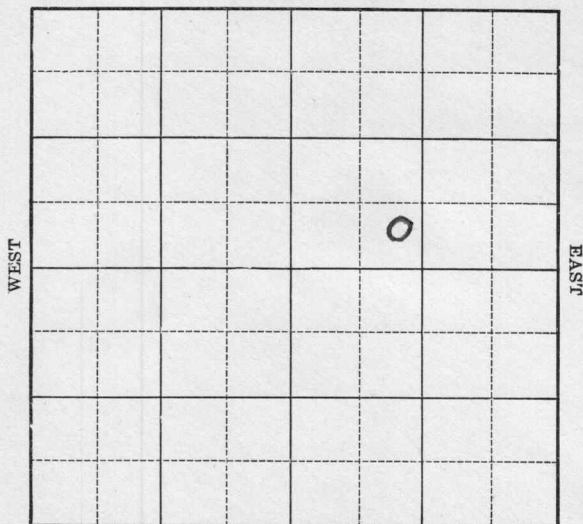

SOUTH

Location _____

Drilling Remarks

Rig Up

Drilling Remarks

RECORD

Cased_____in. _____ft.

Sand _____

Gas

Oil

Total Depth-----

PRODUCTION

1st 24 hrs. Nat. _____

1st 24 hrs. after shot_____

Gas _____ cu. ft.

Dry Hole

Abandoned -----

*Summer*Map No. _____ Sec. *14* Twp. *32* R. *2 E*Well No. *1-Buffington* Farm*La Robb Oil et al* Company*Oxford Lawrence*


_____ Ft. from N. Line

475 Ft. from S. Line

_____ Ft. from E. Line

1250 Ft. from W. Line*1927*

NORTH

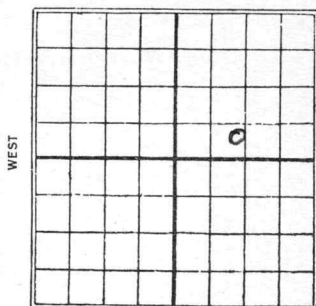

SOUTH

Date

REPORT

<i>7/6</i>	<i>Rig</i>
<i>7/13</i>	<i>Rigging up</i>
<i>7/20</i>	
<i>7/27</i>	<i>Drilg 350</i>
<i>8/3</i>	<i>" 690</i>
<i>8/10</i>	<i>T.D. 690- fishing tools-</i>
<i>8/17</i>	<i>Drilg 1295</i>
<i>8/24</i>	<i>T.D. 1455 - n.R. 10"-</i>
<i>8/31</i>	<i>Drilg 1745</i>
<i>9/7</i>	<i>Top Ad. 1993 show oil pay 2085-</i> <i>2100- T.D. 2100 1/2 -flowed 1000</i> <i>bbls 20 hrs. shut in</i> <i>tanks burned-</i>
<i>9/14</i>	<i>Swabbing + flowing 900 bbls-</i>
<i>9/20</i>	<i>flowing 980 bbls day-</i>
<i>9/28</i>	<i>\$ 1993 T.D. 2100 1/2'</i> <i>1000 bbls</i>


Map No. Sumner KANSAS Sec. 14 Twp. 32 R. 25

Well No. 1 Buffington

La Ross Oil & Gas Company

Oxford Hoernshte Contractor

SECTION PLAT

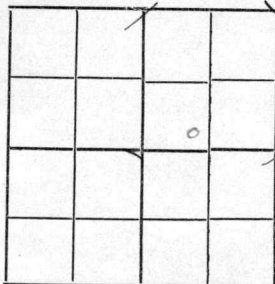

-----Ft. from N. Line

475 Ft. from S. Line

-----Ft. from E. Line

1250 Ft. from W. Line

FIRST REPORTS

Location -----

Rig up -----

Drilling and Remarks:

Rig

RECORD

Cased ----- in., ----- ft.

Sand -----

Gas -----

Oil -----

Total Depth -----

PRODUCTION

1st 24 hrs. Nat. -----

1st 24 hrs. after shot -----

Gas ----- Cu. Ft.

Dry Hole -----

Abandoned -----

Date

JUL 6 1927

192

S. J. LEWIS

Scout


Map No. 1 Samner KANSAS Sec. 14 Twp 32 R. 2E

Well No. 1 Buffington

La Roff Oil & Gas Company

Oxford Township Contractor

SECTION PLAT

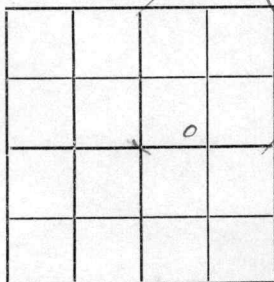

_____ Ft. from N. Line

475 Ft. from S. Line

_____ Ft. from E. Line

1250 Ft. from W. Line

COMPLETED

Location _____

Rig up _____

Drilling and Remarks:

TS 1993

TD 2100 1/2

1000 ft 120 hrs

RECORD

Cased _____ in., _____ ft.

Sand _____

Gas _____

Oil _____

Total Depth _____

PRODUCTION

1st 24 hrs. Nat. _____

1st 24 hrs. after shot _____

Gas _____ Cu. Ft.

Dry Hole _____

Abandoned _____

Date

SEP 28 1927

192

S. J. LEWIS

Scout