
Rush KANSAS

DX 78-1

Section 10 Township 18 Range 18W

Well No. 1 Krug

Company Gulf Oil

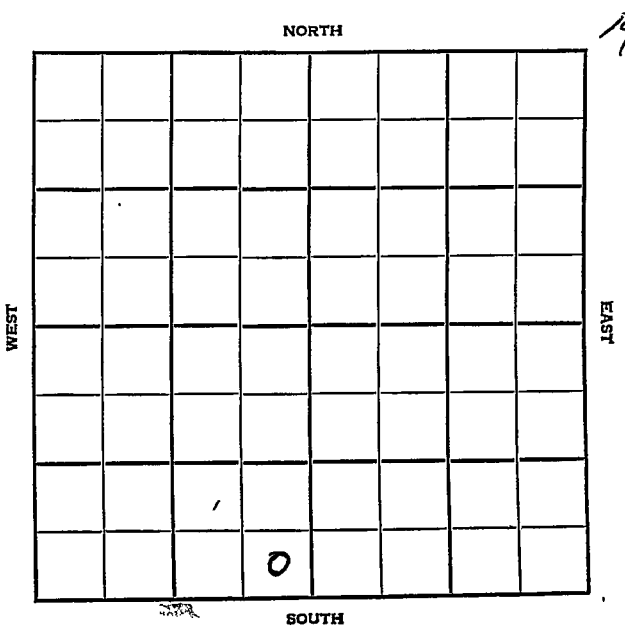

Rush KANSAS

SEC.	TWP.	R.
10	18	18W

WELL NO.

1 Krug FARM

COMPANY

Gulf Oil

CONTRACTOR


NE Rush Center Pool

_____ Ft. from N. Line

330 Ft. from S. Line

330 Ft. from E. Line

_____ Ft. from W. Line

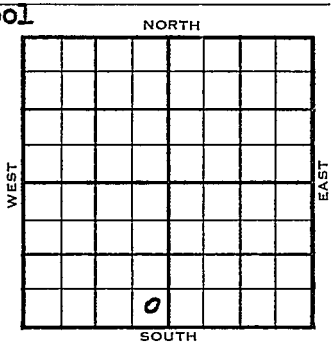

SE SE SW

1954	ELEVATION 2048' REPORT
8/4	Location
8/25	Spud 8-7-54 - D&A TD 3837' Anhy 1214' 8-5/8" @ 1218' Heeb 3391'; Tor 3413', Lans 3444', Cong 3800', Marm. 3752', Arb. 3815' DST 3823-37, opnl hr., rec. 1268' sw, 910# DST 3814-25, opn 1 hr., rec.6' mud, 150# TD 3837' Schl Tops: Heeb 3392', Tor 3411', Lans 3445', B KC 3586', Marm. 3750', Cong. 3801', Arb. 3815' D&A

ABANDONED

DX-78

FORM 275 FOR SALE BY KANSAS BLUE PRINT CO.


County Rush State Kansas

Sec. 10 (Blk. Twp.) 18 (Sur. Rge.) 18W Map No.

Operator Gulf Oil

Well No. 1 Farm Krug

Elev. Location SE SE SW

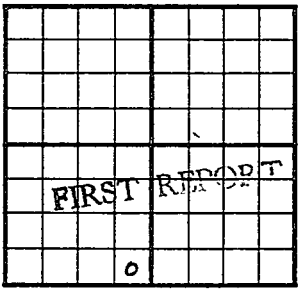

330 Ft. From S Line SW

330 Ft. From E Line Quarter

1st. Report AUG 4 1954

Completion

Remarks

Spudding Date

Drlg. Data NE Rush Center Pool

Location

J. G. McGeneE

FORM 275 FOR SALE BY KANSAS BLUE PRINT CO.


County Rush State Kansas

Sec. 10 (Blk. Twp.) 18 (Sur. Rge.) 18W Map No.

Operator Gulf Oil

Well No. 1 Farm Krug

Elev. 2048 Location SE SE SW

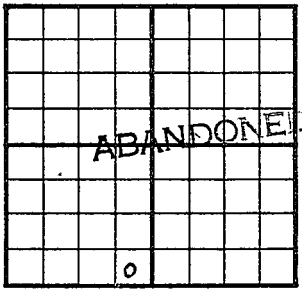

330 Ft. From S Line SW

330 Ft. From E Line Quarter

1st. Report

Completion AUG 25 1954

Remarks NE Rush Center Pool

Anschutz - Contr.

Spudding Date 8-7-54

Drlg. Data D & A TD 3837

Anhy 1214 8 5/8" @ 1218 Heeb. 3391

Tor. 3413 Lans. 3444 Cong. 3800

Marm. 3752 Arb. 3815 DST 3823-37

open 1 hr. Rec. 1268' sw 910#

DST 3814-25 open 1 hr. Rec. 6' mud

150# TD 3837 SCHLUMBERGER TOPS

Heeb. 3392 Tor. 3411 Lans. 3445

B KC 3586 Marm. 3750 Cong. 3801

Arb. 3815

D & A

FABEN GILSTRAP