


DX 78-1 Rush

KANSAS

Section 10 Township 18 Range 18W

Well No. #1 Krug

Company Imperial Drlg.

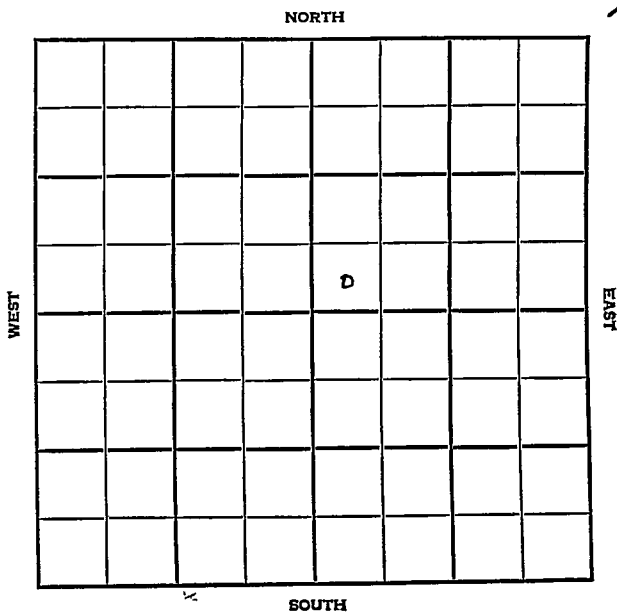

Rush

KANSAS

SEC.	TWP.	R.
10	18	18W

WELL NO.

#1 Krug

FARM

COMPANY

Imperial Drilg.

CONTRACTOR

NE Rush Center Pool

NORTH

Ft. from N. Line


330

Ft. from S. Line

Ft. from E. Line

330


Ft. from W. Line

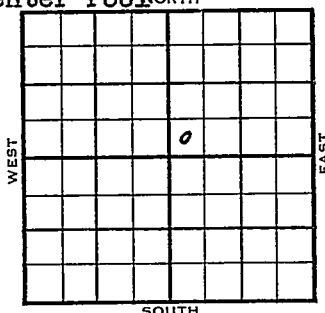

SW SW NE

Ohio F/O

	ELEVATION	REPORT
1954	2055'	
11/17	Location	
1955 1/26	Spud 11-30-54 - Oil Well TD 3827' Anhy 1211' 8" @ 1221' Heeb. 3391', Lans. 3445' DST 3464-76', opn 1 hr., rec. 545' gcsw, 1195# Cong. 3797', Arb. 3800' DST 3464-76' 3464-76' DST 3806-21', opn 2 hrs., rec. 510' gas, 120' muddy oil, 560' oil, 1075# DST 3824-37', opn 1 hr., rec. 210' gas, 850' oil, 1620' SW, 1435# TD 3837' 5" @ 3853' 9/3833-34, CO to 3828 21/3826-27, SSO, 50 M-A B/1 boph 16 hrs., 500A S/30 boph 83/3807-18, S/12½ boph 12 hrs., 1000A, S/39 boph 12 hrs. 1000A, S/39 boph 12 hrs. Comp. 1039 bopd 7% wtr.	

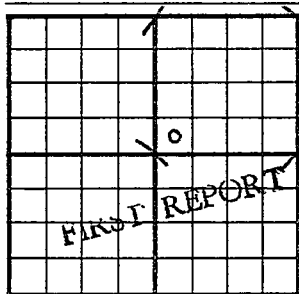County Rush State KansasSec. 10 (Blk. Twp.) 18 (Sur. Rge.) 18W Map No.Operator Imperial Drlg.Well No. 1 Farm KrugElev. Location SW SW NE330 Ft. From S Line NE330 Ft. From W Line Quarter1st. Report NOV 17 1954

Completion


Remarks Ohio farmout

Spudding Date

Drlg. Data NE Rush Center PoolLocation

FABEN GILSTRAP

County Rush State Kansas
 Sec. 10 (Blk. 18) (Sur. 18W) Map No. 18W
 Operator Imperial Drlg.
 Well No. 1 Farm Krug
 Elev. 2055 Location SW SW NE

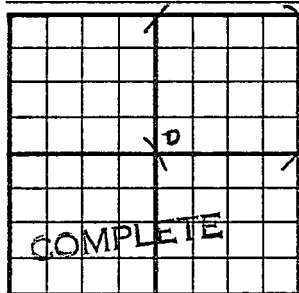

330Ft. From S Line NE

330Ft. From W Line Quarter

1st. Report

Completion JAN 2 6 1955

Remarks NE Rush Center Pool

Spudding Date 11-30-54

Drlg. Data Oil well TD 3837

Anhy 1211 8" @ 1221 Heeb. 3391

Lans. 3445 DST 3464-76 open 1 hr.

Rec. 545' gcsw 1195# Cong. 3797

Arb. 3800 DST 3806-21 open 2 hr.

Rec. 510' gas 120' muddy oil 560' oil

1075# DST 3824-37 open 1 hr. Rec.

210' gas 850' oil 1620' sw 1435#

TD 3837 5" @ 3853 9/ 3833-34

CO to 3828 21/ 3826-27 SSO 50 M-A

B/ 1 boph 16 hr. 500 A S/ 30 boph

83/ 3807-18 S/ 12 $\frac{1}{2}$ boph 12 hr.

1000 A S/ 39 boph 12 hr.

Comp. 1039 bopd 7% wtr.

FABEN GILSTRAP