


Map No. _____ Sec. 14 Twp. 32 R. 2 E
Well No. 2 - Community Farm _____
Rolana Pet Corp Company

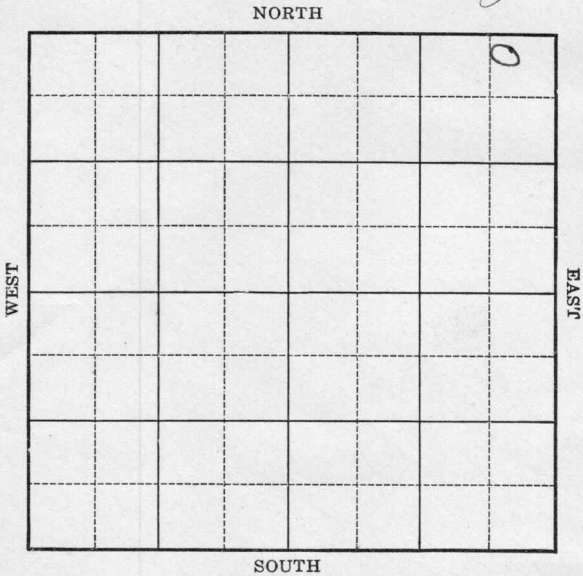

Location _____
Drilling Remarks _____

Rig Up _____
Drilling Remarks _____

RECORD

Cased _____ in. _____ ft.
Sand _____
Gas _____
Oil _____
Total Depth _____

PRODUCTION

1st 24 hrs. Nat. _____
1st 24 hrs. after shot _____
Gas _____ cu. ft.
Dry Hole _____
Abandoned _____

*Summer*Map No. _____ Sec. *14* Twp. *32* R. *2 E*Well No. *2 - Community* Farm*Rocana Pet Corp* Company*Lot 13 Blk 39*


NORTH

220 Ft. from N. Line

_____ Ft. from S. Line

610 Ft. from E. Line

_____ Ft. from W. Line

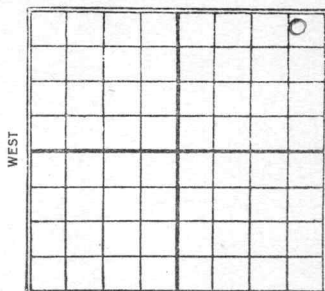

SOUTH

1927

Date

REPORT

<i>8/17</i>	<i>R.O.G.</i>
<i>8/24</i>	<i>Rigging up</i>
<i>8/31</i>	<i>Drlg 360</i>
<i>9/7</i>	<i>" 910</i>
<i>9/14</i>	<i>" 1710</i>
<i>9/20</i>	<i>Top pd- 2062 - T.D. 2133-</i>
	<i>100' oil in hole-</i>
<i>9/28</i>	<i>T.S. 2062 T.D. 2135</i>
	<i>120/ 2077-2135</i>
	<i>561 bbl 17 hrs</i>

Remm
 K1
 Map No. **KANSAS** Sec. *14* Twp. *32* R. *2E*

Well No. *2 Community*

Roxana P. & Co. Company

Cyford Housrite Contractor

Lot 13 Blk. 39

SECTION PLAT

			0

220 Ft. from N. Line

_____ Ft. from S. Line

610 Ft. from E. Line

_____ Ft. from W. Line

FIRST REPORTS

Location _____

Rig up _____

Drilling and Remarks:

RCG

RECORD

Cased _____ in., _____ ft.

Sand _____

Gas _____

Oil _____

Total Depth _____

PRODUCTION

1st 24 hrs. Nat. _____

1st 24 hrs. after shot _____

Gas _____ Cu. Ft.

Dry Hole _____

Abandoned _____

Date

AUG 17 1927

192

S. J. LEWIS

Scout

Map No. KANSAS Sec. 14 Twp. 32 R. 2E

Well No. 2 Community

Roxana P & C. Corp. Company

Cxford townsite Contractor

Lot 13. B1k. 39

SECTION PLAT

			o

220 Ft. from N. Line

_____ Ft. from S. Line

610 Ft. from E. Line

_____ Ft. from W. Line

COMPLETED

Location _____

Rig up _____

Drilling and Remarks:

TS 2062.

TH 2135

120/2077-2135

561886.17 hrs

RECORD

Cased _____ in., _____ ft.

Sand _____

Gas _____

Oil _____

Total Depth _____

PRODUCTION

1st 24 hrs. Nat. _____

1st 24 hrs. after shot _____

Gas _____ Cu. Ft.

Dry Hole _____

Abandoned _____

Date

SEP 28 1927

S. J. LEWIS

192

Scout