


Map No. KANSAS Sec. 35 Twp. 18 R. 21 W.

Well No. 1-Tank Farm Barnsdall Oil Company

NORTH

WEST

EAST

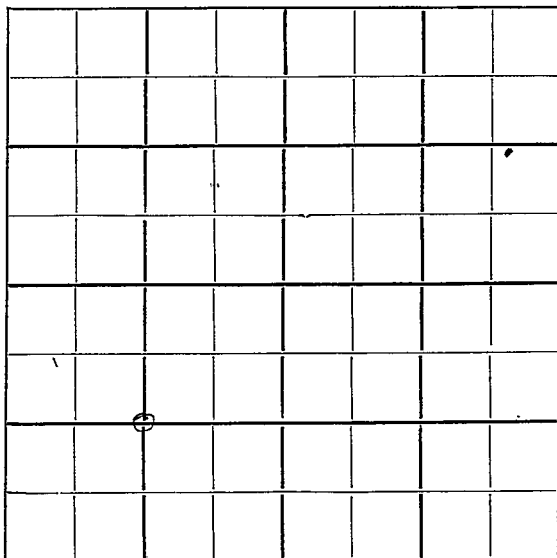

SOUTH

Location.....

Drilling Remarks

.....

.....

RECORD

Cased.....in.....ft.

Sand.....

Gas.....

Oil.....

Total Depth.....

Rig Up.....

Drilling Remarks

.....

.....

PRODUCTION

1st 24 hrs. Nat.....

1st 24 hrs. after shot.....

Gas.....cu. ft.....

Dry Hole.....

Abandoned.....


Map No. KANSAS Sec. 3.5 Twp. 18 R. 21^W
 Well No. 1-Tank Farm
Barnsdall Company

.....Ft. from N. Line

1329 Ft. from S. Line

.....Ft. from E. Line

1320 Ft. from W. Line

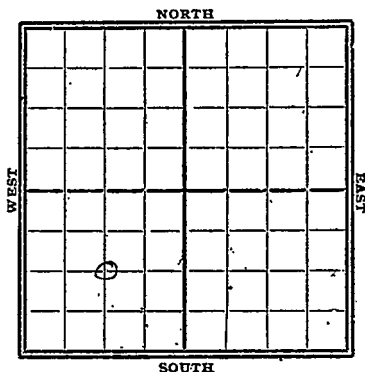

1928

Date

REPORT.

11/21	Location
11/28	Rolls
12/5	
12/12	Reg
12/19	Spud
12/26	
1929	
1/2	VIR 15"-600-TD.
1/9	drlg 750'
1/16	" 773'
1/23	" 1095'
1/30	T.D. 1095' Sem. ?
2/6	drlg 1200'
2/13	" 1398'
2/20	drlg 2275' show gas
2/27	10"-2500'
3/6	drlg 3060'
3/13	" 3200'
3/20	VIR 8"-3407' TD
3/27	run 8"-3407'
4/3	Dodge sand 3640-57
	VIR 8"-3662'-T.D.

- 4/10 - verl 3675'
 4/17 - H.F.W. 3790 verl 3795'
 4/24 - Verl 3939'
 5/1 - " 3978 6" - 3972
 5/8 - sand 4175-77 250' oil
 verl 4182 No increase
 in oil
 5/13 - T.O. 4182' 900' oil
 and 800' water
 5/15 - swabbed 60 bbls oil
 off top water in
 16 hrs
 5/22 - U.R. 4203'
 5/29 - —
 6/5 - 6" - 4208
 6/12 - Chat 4218 Oil 4225'
 T.O. 4229 swabbed 112 bbls
 oil and 108 bbls water
 in 12 hrs - 41.6 gravity
 at 76 temperature
 6/19 - no test
 6/26 - verl 4345'
 7/2 - 5" - 4412 - verl 9
 7/10 - Verl 4455'
 7/17 - " 4614'
 7/24 - T.O. 4755'
 Abandoned


No tracing
 MAP NO. **KANSAS** SEC. 35 TWP. 18 R. 21 W

WELL NO. 1 Tank.

Barnsdall Oil COMPANY

CONTRACTOR

SECTION PLAT

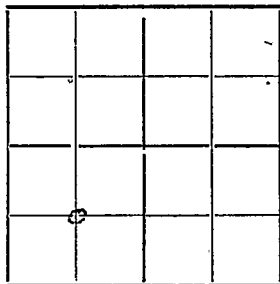

_____ FT. FROM N. LINE

1320 FT. FROM S. LINE

_____ FT. FROM E. LINE

1320 FT. FROM W. LINE

FIRST REPORTS

LOCATION ✓

RIG UP _____

DRILLING AND REMARKS:

RECORD

CASED _____ IN. _____ FT.

SAND _____

GAS _____

OIL _____

TOTAL DEPTH _____

PRODUCTION

1ST 24 HRS. NAT. _____

1ST 24 HRS. AFTER SHOT _____

GAS _____ CU. FT.

DRY HOLE _____

ABANDONED _____

DATE

NOV 21 1928

192

S. J. LEWIS

SCOUT

Map No. W 800 **KANSAS** Sec. 35 Twp. 18 R. 21 W
 Well No. 75 1 Lank

Barnesall Oil Company

Contractor


SECTION PLAT

Ft. from N. Line

1320 Ft. from S. Line

Ft. from E. Line

1320 Ft. from W. Line

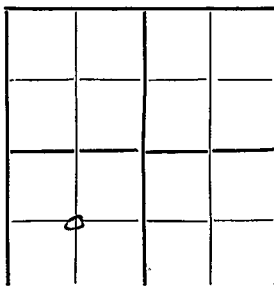

ABANDONED

Location

Rig up

Drilling and Remarks:

RECORD

Cased.....in.,ft.

Sand.....

Gas.....

Oil.....

Total Depth 4755

PRODUCTION

1st 24 hrs. Nat.....

1st 24 hrs. after shot.....

Gas.....Cu. Ft.

Dry Hole.....

Abandoned.....

Date

JUL 24 1929

192

S. J. LEWIS Scout