



Map No. \_\_\_\_\_ Sec. *14* Twp. *32* R. *2E*

Well No. *7-Community* Farm


*Rocana Pet* Company

*170* Ft. from N. Line

\_\_\_\_\_ Ft. from S. Line

*975* Ft. from E. Line

\_\_\_\_\_ Ft. from W. Line

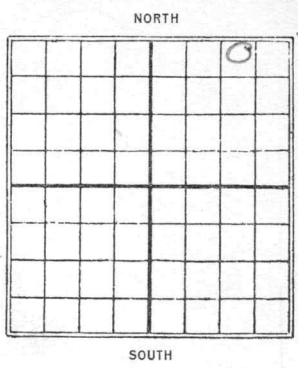

*1987*

Date	REPORT
<i>10/26</i>	<i>Rig Bldg</i>
<i>11/2</i>	<i>Spind</i>
<i>11/9</i>	<i>Drlg 730</i>
<i>11/16</i>	<i>" 1265</i>
<i>11/22</i>	<i>" 1740 - show oil 1705-10</i>
<i>11/29</i>	<i>Top sd. 2061 - drlg 2062 -</i>
<i>12/7</i>	<i>Top sd. 2054 - (SLM) - T.D. 2114</i>
	<i>shot 80 gts 2072 - 2112 - 400' oil in hole</i>
<i>12/14</i>	<i>No test</i>
<i>12/21</i>	<i>Top sd. 2054 T.D. 2114</i>
	<i>80 / 2072 - 2112</i>
	<i>75 bbls</i>

Map No. **KANSAS** Sec. 14 Twp. 32 R. 2E

Well No. 7 Community

Roxana Petroleum Corp. Company

Oxford Townsite Contractor

Lot 7, Blk 38

**SECTION PLAT**

			0

170 Ft. from N. Line

----- Ft. from S. Line

975 Ft. from E. Line

----- Ft. from W. Line

**FIRST REPORTS**

Location -----

Rig up -----

Drilling and Remarks:

*Rig Bldg*

**RECORD**

Cased ----- in., ----- ft.

Sand -----

Gas -----

Oil -----

Total Depth -----

**PRODUCTION**

1st 24 hrs. Nat. -----

1st 24 hrs. after shot -----

Gas ----- Cu. Ft.

Dry Hole -----

Abandoned -----

Date

OCT 26 1927

192

S. J. LEWIS

Scout

Map No. **KANSAS** Sec. 14 Twp. 32 R. 2E

Well No. 7 Community

Roxana P. & O. Corp. Company

Oxford Townsite Contractor

Lot 7 Blk. 38.

**SECTION PLAT**

		1	0

170 Ft. from N. Line

----- Ft. from S. Line

975 Ft. from E. Line

----- Ft. from W. Line

**COMPLETED**

Location -----

Rig up -----

Drilling and Remarks:

T/D. 2054

T/D 2014

80/2072-2112.

758 1/2.

**RECORD**

Cased ----- in., ----- ft.

Sand -----

Gas -----

Oil -----

Total Depth -----

**PRODUCTION**

1st 24 hrs. Nat. -----

1st 24 hrs. after shot -----

Gas ----- Cu. Ft.

Dry Hole -----

Abandoned -----

Date

DEC 21 1927

**S. J. LEWIS**

Scout