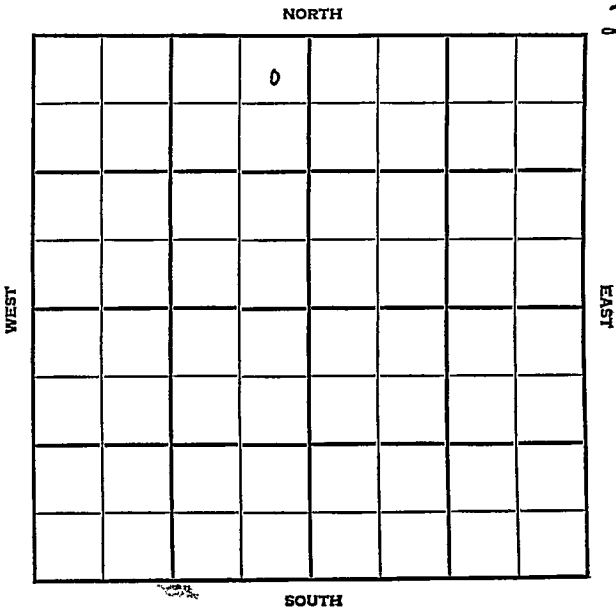


Section 14 Township 18 Range 18WWell No. #1 SellCompany D.R. Lauck

Rush KANSAS

SEC.	TWP.	R.
14	18	18 W

WELL NO.

1 Sell

FARM

COMPANY

D. R. Lauck

CONTRACTOR

Co. tools

Wildcat


330 Ft. from N. Line

Ft. from S. Line

330 Ft. from E. Line

Ft. from W. Line

NE NE NW

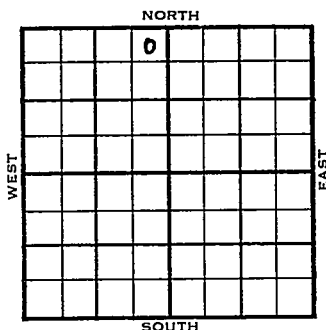

	ELEVATION	REPORT
1954	2070'	

12/29 RUR

1955

1/12

Spud 12-22-54 - D&A

TD 3938'

8" @ 1017'

Heeb. 3411', Tor. 3431', Lans 3468',

Marm. 3778', Cong. 3825', Arb. 3867'


DST 3485-3500', opn 1/2 hrs., rec. 20'

mud, 750#

TD 3938'

D&A

ABANDONED

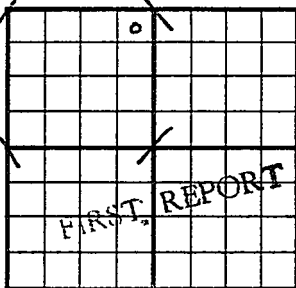County Rush State KansasSec. 14 (Blk. 18 (Sur. 18W Map No. 18W)
(Twp.) (Rge.)Operator D. R. LanckWell No. 1 Farm SellElev. _____ Location NE NE NW330 Ft. From N Line NW330 Ft. From E Line QuarterIst. Report DEC 29 1954

Completion _____


Remarks _____

Co. tools

Spudding Date _____

Drlg. Data WildcatRUR

FABEN GILSTRAP

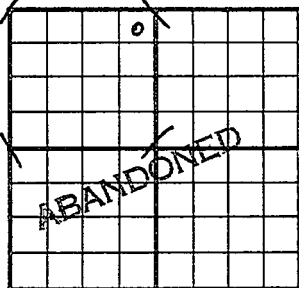County Rush State KansasSec. 14 (Blk.
Twp.) 18 (Sur.
Rge.) 18W Map No.Operator D. R. LauckWell No. 1 Farm SellElev. 2070 Location NE NE NW330 Ft. From N Line NW330 Ft. From E Line Quarter

1st. Report

Completion JAN 1 2 1955Remarks Wildcat

Co. tools

Spudding Date 12-22-54Drlg. Data D & A TD 39388" @ 1017 Heeb. 3411 Tor. 3431Lans. 3468 Marm. 3778 Cong. 3825Arb. 3867 DST 3485-3500 open $\frac{1}{2}$ hr.Rec. 20' mud 750# TD 3938D & A

FABEN GILSTRAP