


DX 78-1 Rush

KANSAS

Section 10 Township 18 Range 18W

Well No. 3 Krug "A"

Company Imperial Drlg.

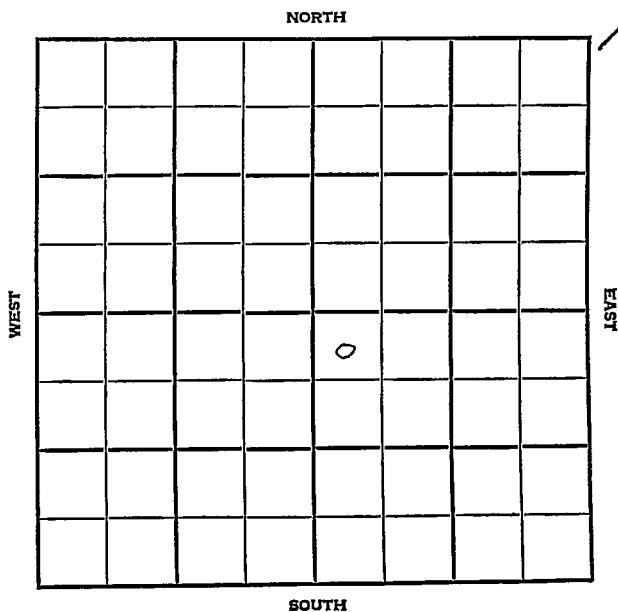

Rush

KANSAS

|      |      |      |
|------|------|------|
| SEC. | TWP. | R.   |
| 10   | 18   | 18 W |

WELL NO.

# 3 Krug "A"

FARM

COMPANY

Imperial Drllg.

CONTRACTOR

Harms &amp; Burt

NE Rush Center Pool


330 Ft. from N. Line

Ft. from S. Line

Ft. from E. Line

330 Ft. from W. Line

NW NW SE

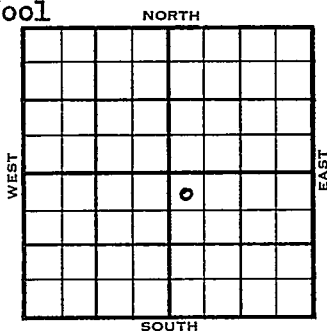

1955

ELEVATION

REPORT

4/27

Spudding.

County Rush State KansasSec. 10 (Blk. (18)) (Sur. Rge.) 18W Map No.Operator Imperial Drlg.Well No. 3 Farm Krug "A"Elev. Location NW NW SE

|  |  |  |  |  |  |  |  |
|--|--|--|--|--|--|--|--|
|  |  |  |  |  |  |  |  |
|  |  |  |  |  |  |  |  |
330 Ft. From N Line SE330 Ft. From W Line Quarter1st. Report APR 27 1955

Completion

Remarks

Harms & Burt - Contr.

Spudding Date

Drlg. Data

NE Rush Center Poolspdg.

K-14

FABEN GILSTRAP