


Section 15 Township 18 Range 18W

Well No. #2 Dirks

Company Imperial Drig.

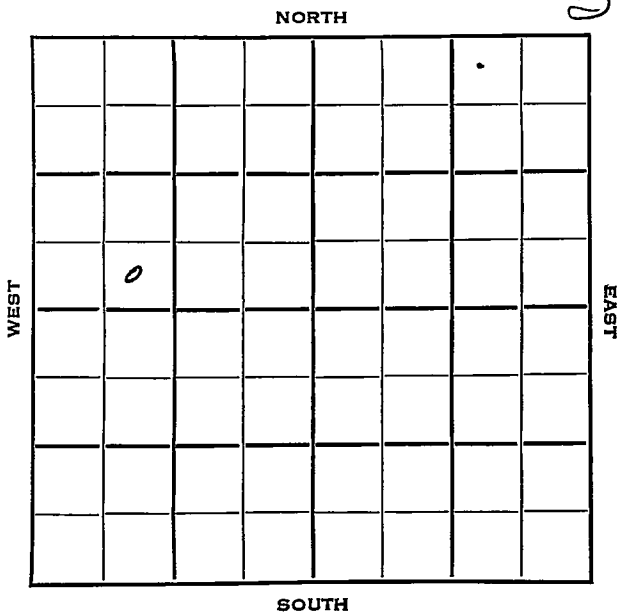

Rush KANSAS

SEC.	TWP.	R.
15	18	18W ✓

WELL NO. 2 Dirks FARM

COMPANY Imperial Drlg.


CONTRACTOR Imperial

Rush Center Pool  
 \_\_\_\_\_ Ft. from N. Line

330 \_\_\_\_\_ Ft. from S. Line

\_\_\_\_\_ Ft. from E. Line

990 \_\_\_\_\_ Ft. from W. Line

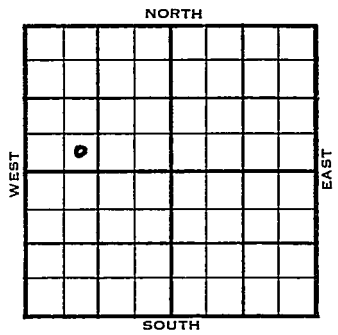

SE SW NW

	ELEVATION	REPORT
1954	2083'	
3/17		Spud 3-14-54 8" @ 1247', WOC.
3/24		Anhy 1235', Heeb 3408', Lans 3463' Drlg. 3510'
3/31		Marm <del>363</del> 3765 Arb. 3808 RTD 3811 5" @ 3811
4/7		DD 3819' 1 boph DD 3825' TD FU @ rate 12 BOPH S/30 BOPH 2 hrs. FU 2900' oil, 1000A S/70 BOPH 3 hrs., 2000' OB
4/14		Spud 3-14-54 Oil Well TD 3825' 8" @ 1247' Anhy 1235', Heeb 3408', Lans 3463' Marm 3765', Arb 3808' TD 3811' 5" @ 3811' DD 3819' 1 boph DD3825' FU 12 goph S/ 30 boph 2 hr. FU 2900' oil 1000 A S/ 70 boph 3 hr. Comp 3000 bopd.

**COMPLETED**



