

Rush


DX 78-1

KANSAS

Section 15 Township 18 Range 18W

Well No. #3 Dirks

Company Imperial Drig.

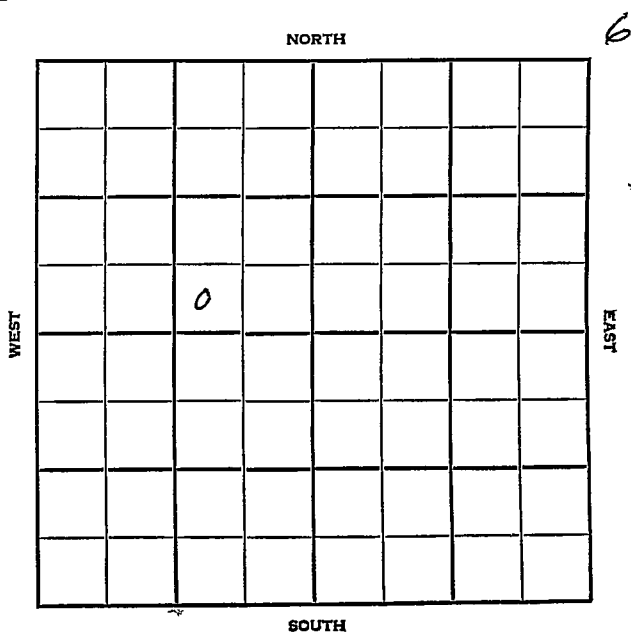

Rush KANSAS

SEC.	TWP.	R.
15	18	18W

WELL NO. 3 Dirks FARM

COMPANY

CONTRACTOR Imperial Drlg.


Rush Center Pool

_____ Ft. from N. Line

330 _____ Ft. from S. Line

990 _____ Ft. from E. Line

_____ Ft. from W. Line

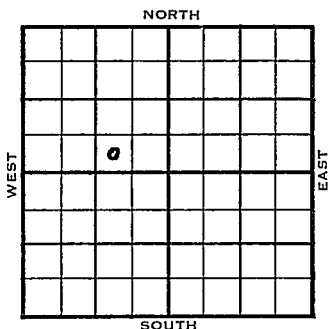

SW SE NW

1954	ELEVATION	REPORT
	2081'	

5/5

Location

5/12

Anhy 1230'
8" @ 1240'
Drlg. 2205'

5/19

Spud 5-7-54 D & A TD 3905
Anhy 1230 8" @ 1240 Heeb 3420
Lans. 3474 Marm. 3488 Cong. 3830
Arb. 3877 TD 3905 D & A

ABANDONED

