


Section 15 Township 18 Range 18W

Well No. 3 H. O. Jones

Company Sinclair

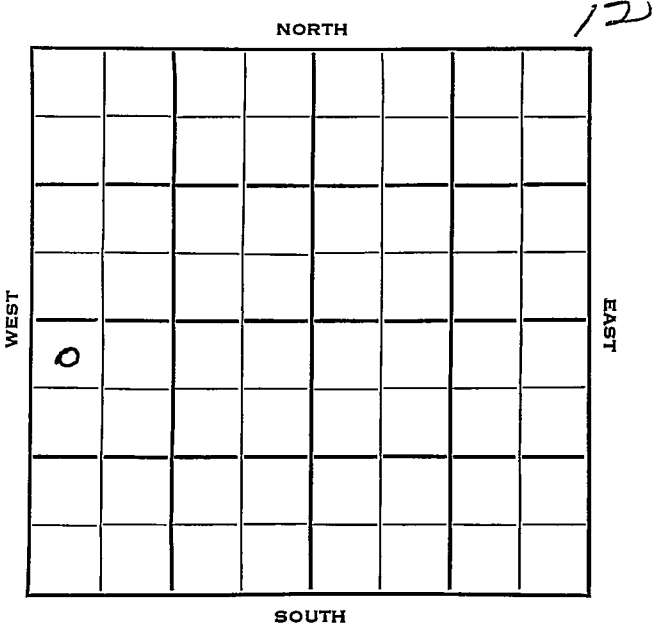

Rush

KANSAS

SEC.	TWP.	R.
15	18	18W ✓

WELL NO. _____
 3 H. O. Jones FARM

COMPANY _____
 Sinclair

CONTRACTOR _____


Rush Center Pool

330 _____ Ft. from N. Line

_____ Ft. from S. Line

_____ Ft. from E. Line

330 _____ Ft. from W. Line

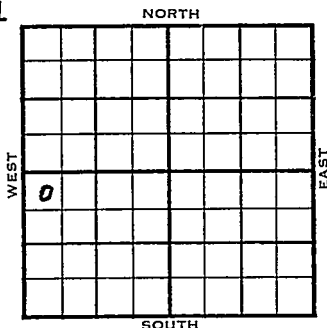

NW NW SW

1953	ELEVATION	REPORT
	2089'	
9/16		Location
9/23		Drlg. 200'
9/30		Drlg 2690'
10/7		Heeb 3414' Lans 3467' Drlg. 3675'
11/4		NR
11/11		Spud 9-22-53 Oil Well TD 3826' 9" @ 995' Heeb 3414', Lans 3467', Arb 3808' DST 3810'-15' opn 1 hr, rec 210' ocm, 880#. DST 3808'-15' opn 6 hr, rec 620' clean gassy oil, 930# TD 3815' 5" @ 3807' DD 3826' S/ 83 bo 7 hr. 1000 A S/ 109 bo 1 hr. Comp 3000 bopd.

COMPLETED

