


Section 15 Township 18 Range 18W

Well No. 4 H. O. Jones

Company Sinclair & Westpan Hydrocarbon

NORTH

12

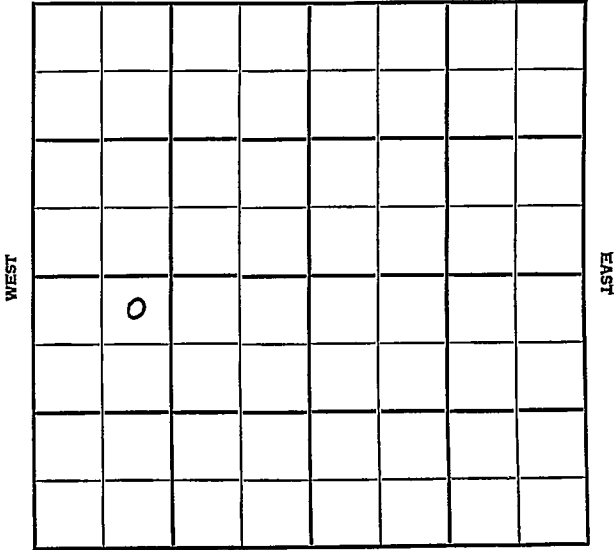

SOUTH

[Faint, illegible stamp or signature]

Rush KANSAS

SEC. 15	TWP 18	R. 18W
------------	-----------	-----------

WELL NO. 4 H. O. Hones FARM
COMPANY

Sinclair & Westpan Hydrocarbon

CONTRACTOR Mallonee


Rush Center Pool

330 Ft. from N. Line

Ft. from S. Line

Ft. from E. Line

990 Ft. from W. Line

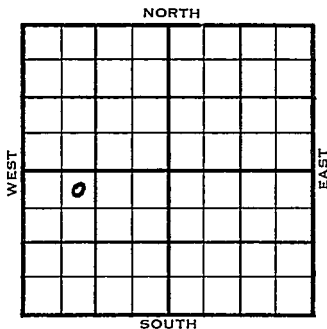

NE NW SW

1954	ELEVATION 2089'	REPORT
------	--------------------	--------

14/7 Location

7/21 8" @ 928'
Drlg. 1880'

9/1 Spud 7-13-54
Oil Well
TD 3851'
8" @ 928'
Top 3177', Heeb 3424' Tor 3445'
KC 3476', Marm 3733' Arb 3843'
TD 3851'
5" @ 3845'
CO to 3851'
S/ 144 bo 11 hr.
Comp 2650 bopd.

COMPLETED

