

Section 16 Township 18 Range 18W

Well No. 1 Dirks

Company Gabbert & Jones

NORTH

16

WEST

EAST


							0

SOUTH

Sec. 16 Twp. 18 R. 18W

Well No. #1 Dirks Farm
Gabbert & Jones Company
Gabbert & Jones Contractor

..... Ft. from N. Line
330 Ft. from S. Line
330 Ft. from E. Line
..... Ft. from W. Line

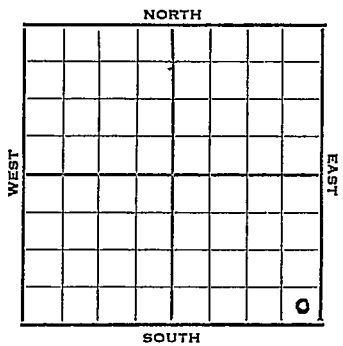

SE SE SE

1952 Elev. 2063' REPORT

- 12/10 Cellar & Pits
- 12/11 " " "
- 12/18 8" @ 915
- 12/25 " "
- 1/1 Drlg. 3310
- 1/8 Heeb 3392 Tor 3414 Lasn 3452 BKC 3708
Morm 3717 Cong 3791 Arb 3825 DST 3826-
37 3/4 Hr. 1920' GCO 1150# RTD 3837
5" @ 3826 CO 3827 FU 3600' Oil S/96
BO 4 Hrs.
- 1/23 NR
- 1/29 "
- 2/5 NR
- 2/12 NR
- 2/19 NR
- 2/26 "
- 3/12 NR
- 3/19 NR
- 3/26 NR
- 4/2 NR

OVER

1953

4/8

Spud 12-13-52

Oil well TD 3837' 8" @ 915

Heeb 3392 Tor. 3414 Lans 3452

B KC 3708 Marm. 3717 Cong. 3791

Arb. 3825

DST 3826-37 open 3/4 hr, rec 1920'

GCO TD 3837 5" @ 3826 CO to 3837

FU 3600' oil S/96 BO 4 hr.

Comp. 428 BOPD 13% wtr.

COMPLETED

