

Rush


KANSAS

FORM 51 IOM 12-46 PETROL

Section 16 Township 18 Range 18W

Well No. 1 Dirks

Company Great Lakes Carbon et al

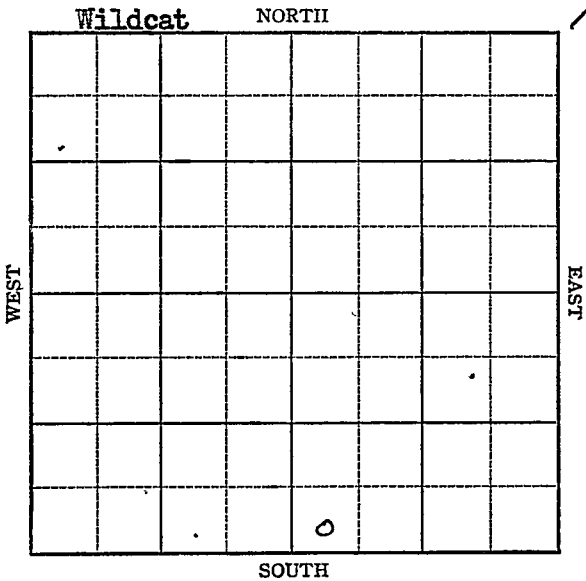

KANSAS

Rush

Sec. 16 Twp. 18 R. 18-W

Well No. #1 Dicks Farm

Great Lakes Carbon etal Company  
Wildcat


Ft. from N. Line

330 Ft. from S. Line

Ft. from E. Line

330 Ft. from W. Line

SW SE

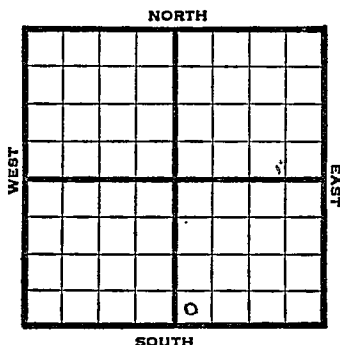

1947 Elev. 2074' REPORT

4/30 Location

5/7 RUR

5/13 8" @ 1235'  
Drlg. 2202'5/20 Topeka 3145  
Drlg 3365'5/27 Lañsing 3445' ?  
Arguckle 38368'  
Drlg. 3840'6/3 TD 3865'  
5" @ 3838  
RUST6/10 Swb 13½ bbls oil & 5 W in  
4½ hrs.

6/17 " " "

6/24 " " "

7/1 " " "

7/8 " " "

7/15 " " "

OVER

1947

7/23 Arbuckle 3836'  
5" @ 3838'  
Pump 122 Oil / 50 % W Pot.  
Gr. 36  
T.D. 3865'  
Complete

3836  
2074  

---

1762

**COMPLETED**

Kansas


K<sub>2</sub>Map No. 74 Sec. 16 Twp. 18 R. 18WWell No. 1 DirksGreat Lakes Carbon etal. Company

## FIRST REPORT

Contractor

SW SE

## SECTION PLAT

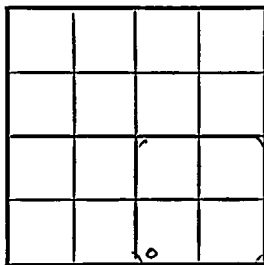       Ft. from N. Line330 Ft. from S. Line       Ft. from E. Line330 Ft. from W. LineRush CountyLocation XRig up       

Drilling and Remarks:

## RECORD

Cased        in.,        ft.Sand       Gas       Oil       Total Depth       

## PRODUCTION

1st 24 hrs: Nat.       1st 24 hrs. after shot       Gas        Cu. Ft.Dry Hole       Abandoned       

Date

APR 30 1947

19


S. J. LEWIS Scout

Map No. 74 Sec. 16 Twp. 18 R. 18WWell No. 1 DirksGreat Lakes Carbon etal. Company

COMPLETE

Contractor

SW SE

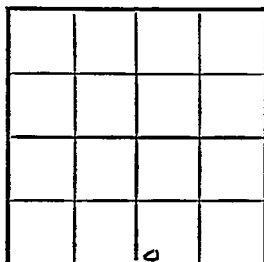*E1.2074*  
SECTION PLAT       Ft. from N. Line330 Ft. from S. Line       Ft. from E. Line330 Ft. from W. Line

Rush County

Location                     Rig up                     

Drilling and Remarks:

*Ce 83886**5"-83838**Pump 122 oil +**50% H/P**86 1/2*

## RECORD

Cased        in.,        ft.Sand                     Gas                     Oil                     Total Depth 3865

## PRODUCTION

1st 24 hrs. Nat.                     1st 24 hrs. after shot                     Gas                      Cu. Ft.Dry Hole                     Abandoned                     

Date

JUL 23 1947 19

S. J. LEWIS Scout