


Section 15 Township 18 Range 18W

Well No. #1 Dirks

Company C. L. McMahon, Inc. & Koester et al

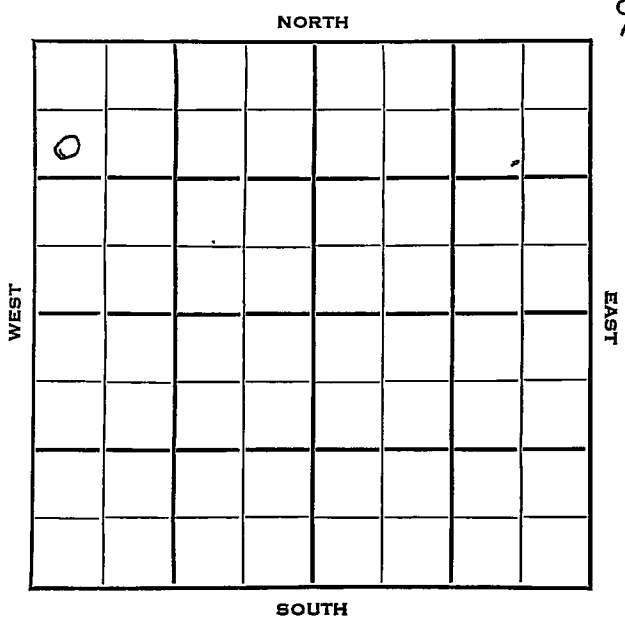

Sec. 15 Twp. 18 R. 18 W

Well No. # 1 Dirks Farm

C. L. McMahon Inc. & Koester et al
Company

Contractor


990 Ft. from N. Line

Ft. from S. Line

Ft. from E. Line

330 Ft. from W. Line

SW NW NW

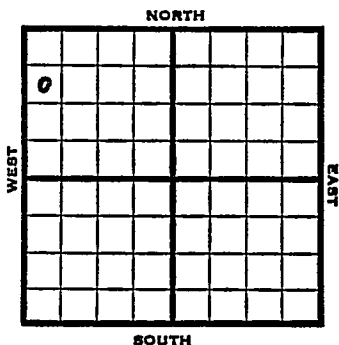

1953 Elev. 2076' REPORT

9/2 Location
 9/9 Anhy 1238'
 8" @ 1245'
 9/16 Heeb 3418, Lans 3471
 Drlg. 3748'
 9/23 Spud 9-6-53
 D & A
 TD 3930'
 Anhy 1238'
 8" @ 1245'
 Heeb 3418', Lans 3471, Cong 3860,
 Arb 3897'
 TD 3930'
 D & A

ABANDONED

