


Section 22 Township 18 Range 18W

Well No. 1 Dirks

Company Musgrove Pet.

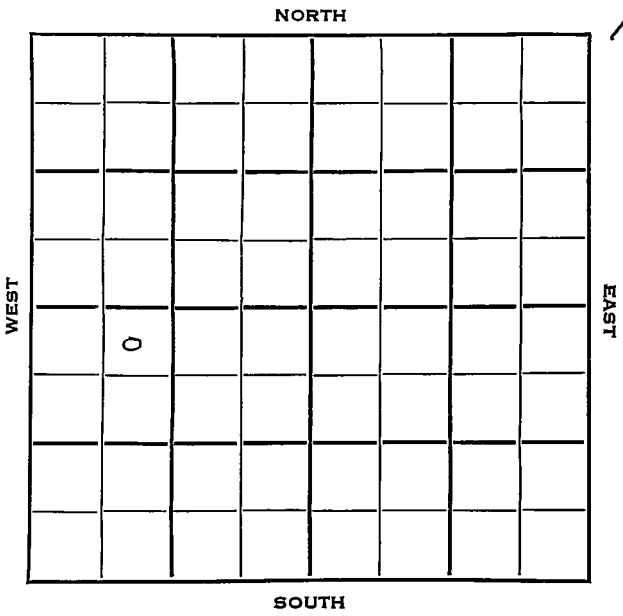

Rush

KANSAS

Sec. 22 Twp. 18 R. 18W

Well No. 1 Dirks Farm

Musgrove Pet. Company

Wildcat Contractor


330 Ft. from N. Line

\_\_\_\_\_ Ft. from S. Line

\_\_\_\_\_ Ft. from E. Line

990 Ft. from W. Line

NE NW SW

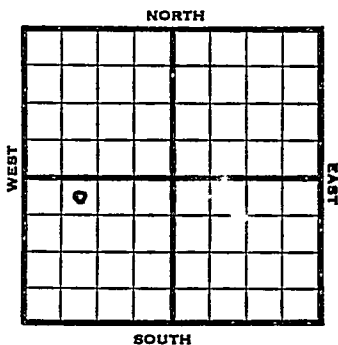

1953 Elev. 2016' REPORT

- 4/1 Drlg 400
- 4/9 8" @ 958 Anhy 1158  
Drlg. 2869'
- 4/16 Heeb 3352, Tor 3373, Lans 3405,  
B KC 3670, Cong 3755, Arb 3785  
DST 3786-90, 1 hr., 360' gas, 510'  
gco, 90' ocm  
D ST 3420-34, 1 1/2 hrs., 35' O&GCM  
195#  
RTD 5790  
5" @ ?
- 4/23 5 1/2" @ 3788
- 4/30 CO 3790 S/4 BO 1st hr. 5% wtr.  
S/6 BOPH plus 6% wtr. Last 3 hrs of 12  
hour test.
- 5/7 NR

**OVER**

#1 Dirks

1953  
5/20

Spud 3-31-53

Oil Well

TD 3790

8" @ 958

Anhy 1158, Heeb 3352, Tor 3373, Lans  
3405, B KC 3670, Cong 3755, Arb 3785

DST 3786-90, opn 1 hr., rec. 360'

gas, 510' gco, 90' ocm

DST 3420-34, opn 1½ hrs., rec. 35'

o & gcm, 195#

TD 3790

5" @ 3788

CO to 3790

S/4 bo 1 hr., 5% wtr.

S/6 boph 6% wtr.

Comp. 325 bopd 2% wtr.

**COMPLETED**


County Rush State Kansas

Sec. 22 (Blk. Twp.) 18 (Sur. Rge.) 18W Map No.

Operator Musgrove Pet.

Well No. 1 Farm Dirks

Elev. \_\_\_\_\_ Location NE NW SW

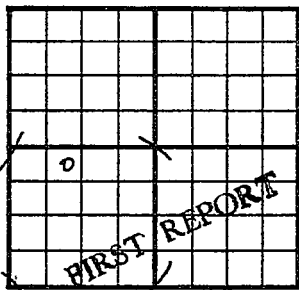

330 Ft. From N Line SW

990 Ft. From W Line Quarter

Ist. Report APR 1 1953

Completion \_\_\_\_\_

Remarks \_\_\_\_\_

Spudding Date 3-31-53

Drlg. Data Wildcat

drlg. 400

County Rush State Kansas

Sec. 22 (Blk. Twp.) 18 (Sur. Rge.) 18W Map No.

Operator Musgrove Pet.

Well No. 1 Farm Dirks

Elev. 2016 Location NE NW SW


330 Ft. From N Line SW

990 Ft. From W Line Quarter

Ist. Report

Completion MAY 20 1953

Remarks Wildcat

Spudding Date 3-31-53

Drig. Data Oil well TD 3790

8" @ 958 Anhy 1158 Heeb. 3352

Tor. 3373 Lans. 3405 B KC 3670

Cong. 3755 Arb. 3785 DST 3786-90

open 1 hr. Rec. 360' gas 510' gco

90' ocm DST 3420-34 open 1½ hr.

Rec. 35' o & gcm 195# TD 3790

5" @ 3788 CO to 3790 - S/ 4 bo 1 hr.

5% wtr. S/ 6 boph 6% wtr.

Comp. 325 bopd; 2% wtr.

J. G. McGEHEE