


Section 34 Township 18 S Range 18 W

Well No. #1 T. T. House

Company Champlin Ref. Co.

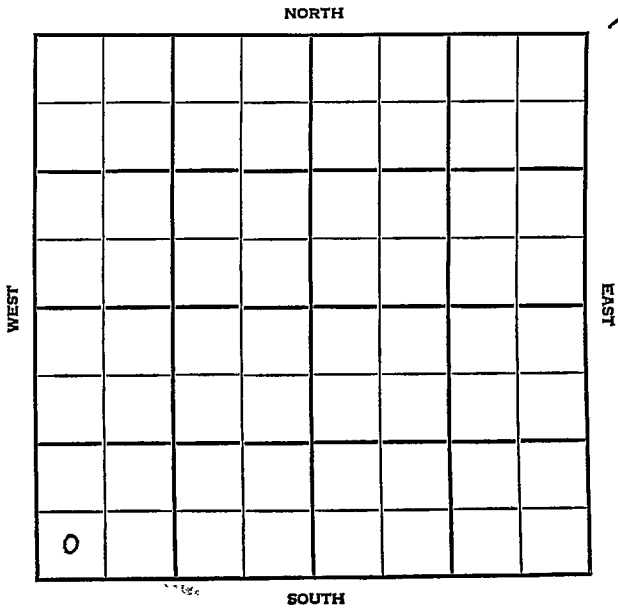

Rush

KANSAS

SEC.	TWP.	R.
34	18S	18W

WELL NO. #1 T. T. House FARM

COMPANY Champlin Ref Co.

CONTRACTOR Armer


Wildcat

_____ Ft. from N. Line

_____ Ft. from S. Line

_____ Ft. from E. Line

_____ Ft. from W. Line

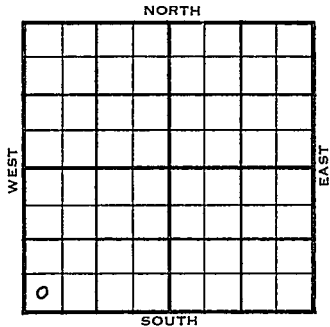

SW SW SW

Warren Pet DHM

1955	ELEVATION	REPORT
	2103'	

9/28 Loc.

10/19

Comm 9-29-55
 8 5/8" @ 1030/300
 H 3461 3462
 Tr 3481 3480
 L 3512 3514
 BKG 3777 3790
 Marm ~~3792~~ 3799
 Sd 3870 3888
 Base Sd 3875
 A 3918 3918
 TD 3977
 DST 3870-85
 open 2 hr Red 1' mud 340/20"
 DST 3921-77 open 2 hr Rec 1050' sw
 1040/20"
 D & A

ABANDONED

County Rush Elev. 2103
 Sec. 31 Twp. 18 Rge. 18W
 Company Champlin Ref.
 Farm Name T. T. House No. 1

TOPS	DEPTH	LOG	DATUM
Anh.			
Ip.			
H.	<u>3461</u>	<u>3462</u>	<u>1359</u>
Tr.	<u>3481</u>	<u>3480</u>	<u>1377</u>
Dg.			
Bl.			
L.	<u>3512</u>	<u>3514</u>	<u>1411</u>
K.C.			
B.K.C.	<u>3777</u>	<u>3790</u>	<u>1687</u>
Ce. <u>Marm</u>		<u>3799</u>	<u>1694</u>
C. <u>sd.</u>	<u>3870</u>	<u>3888</u>	<u>1785</u>
M. <u>Base sd.</u>	<u>3875</u>		<u>1772</u>
M.			
K.			
Mz.			
Ma.			
V.			
S.			
S.			
A	<u>3918</u>	<u>3918</u>	<u>1815</u>
R.			
Pe.			
G.			
T.D.	<u>3977</u>		

Loc. in Sec. SW SW SW
 Geol. _____
 Contr. Armer
 Pool Wildcat

ABANDONED

Date Comm. 9-29-55 OCT 19 1955
8 5/8" @ 1030/300 DST 3870-85
open 2 hr. rec. 1' mud 340/20"
DST 3921-77 open 2 hr. rec. 1050' SW
1040/20"

D & A

Co.
Lse.
No.
Sec.
T.
R.