


DX 78-1

Section 16 Township 18 Range 18W

Well No. 2 Dirks

Company Gabbert-Jones Drlg.

9

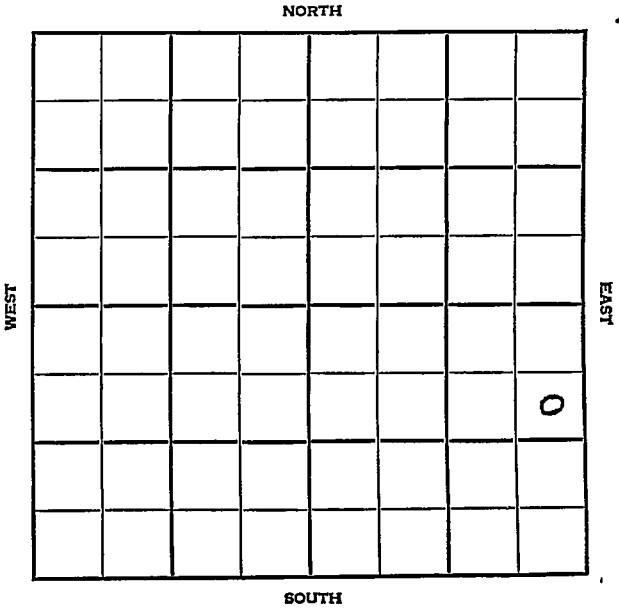

Rush KANSAS

| | | |
|------|------|-----|
| SEC. | TWP. | R. |
| 16 | 18 | 18W |

WELL NO. **2 Dirks** FARM

COMPANY **Gabbert-Jones Drlg.**

CONTRACTOR **Gabbert-Jones**


Rush Center Pool

990 _____ Ft. from N. Line

_____ Ft. from S. Line

330 _____ Ft. from E. Line

_____ Ft. from W. Line

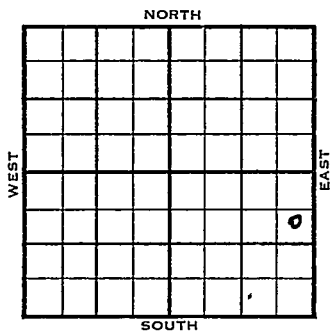

SE NE SE

| | ELEVATION | REPORT |
|------|-----------|--|
| 1954 | 2083' | |
| 6/30 | | Spudding 6-27-54 Drlg. 931 |
| 7/7 | | 8" @ 1016 Drlg. 3550' |
| 7/14 | | Spud 6-27-54 D&A TD 3859' 8" @ 1016' Heeb 3425', Lans 3476', B KC 3741', Marm. 3750', Cong 3832' TD 3859' D&A |

ABANDONED

