

Section 30 Township 18 Range 19WWell No. #1 FelderCompany Toklan Prod.

NORTH

8

|  |  |  |  |  |  |  |   |
|--|--|--|--|--|--|--|---|
|  |  |  |  |  |  |  |   |
|  |  |  |  |  |  |  |   |
|  |  |  |  |  |  |  |   |
|  |  |  |  |  |  |  | 0 |
|  |  |  |  |  |  |  |   |
|  |  |  |  |  |  |  |   |
|  |  |  |  |  |  |  |   |
|  |  |  |  |  |  |  |   |

SOUTH

WEST

EAST

Rush

KANSAS

Sec. 30 Twp. 18 R. 19 WWell No. # 1 Felder FarmToklan Prod.

Company


Salina Drlg.

Contractor

Wildcat         Ft. from N. Line330 Ft. from S. Line330 Ft. from E. Line         Ft. from W. Line

SE SE NE

Atlantic-BHM

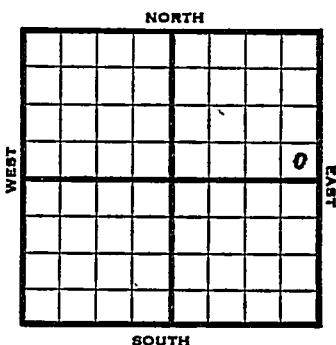

1953 Elev. 2119' REPORT

8/19 Spud 8-15-53  
8" @ 240  
Drlg. 1347'

8/26 Anhy 1320' Heeb 3570' Lans 3614'  
Drlg. 3635'

~~IX~~

9/2

Spud 8-15-53

D&amp;A

TD 4207

8" @ 240

Anhy 1320, Heeb 3570, Lans 3614

DST 3815-25, opn 3/4 hrs., rec. 218'  
sw, 1280#

B KC 3924, Cong 4038, Viola 4078

DST 4020-90, opn 1/2 hrs., rec. 1800'

sw


Simp 41149, Arb. 4169

TD 4207

D&amp;A

ABANDONED

**J. G. McGEHEE**

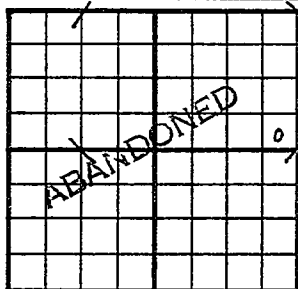County Rush State KansasSec. 30 (Blk.  
Twp.) 18 (Sur.  
Rge.) 19W Map No.Operator Toklan Prod.Well No. 1 Farm FelderElev. 2119 Location SE SE NE330 Ft. From S Line NE330 Ft. From E Line Quarter1st. ReportCompletion SFP 2 1953Remarks WildcatSalina Drlg. - Contr.Spudding Date 8-15-53Drlg. Data D & A TD 42078" @ 240 Anhy 1320 Heeb. 3570Lans. 3614 DST 3815-25 open 3/4 hr.Rec. 218' sw 1280# B KC 3924Cong. 4038 Viola 4078 DST 4020-90open  $\frac{1}{2}$  hr. Rec. 1800' sw Simp. 4149Arb. 4169 TD 4207D & A