

Rush

KANSAS


SECTION 5 TOWNSHIP 18 RANGE 20 1ST

WELL NO. #1 Chess Irvin

COMPANY Sunray Mid-Continent

NORTH

//

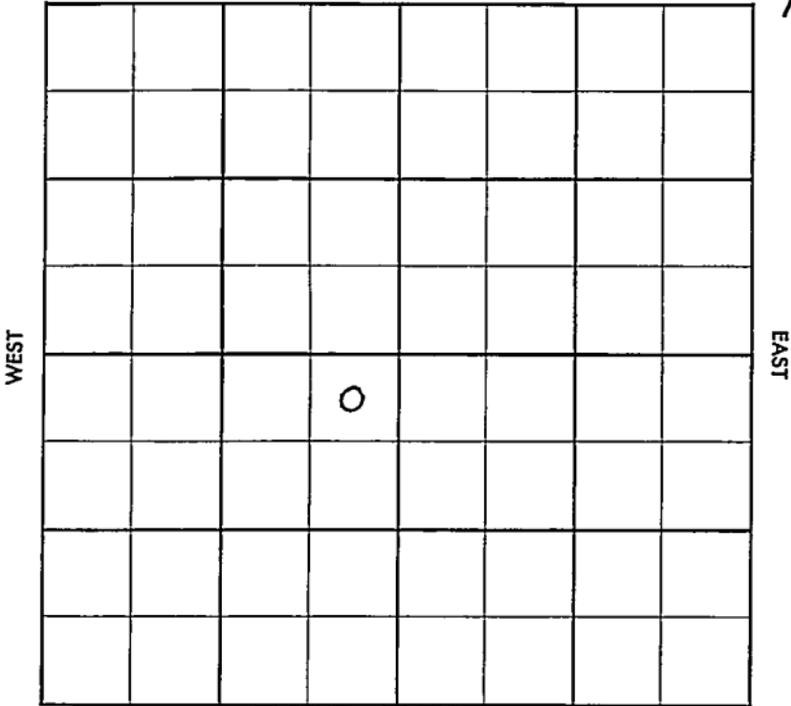

SOUTH

SEC. 5 TWP. 18 S R. 20 W

WELL NO. # 1 C. Irvin FARM

COMPANY Sunray Mid-Continent (EXPLORATORY)

CONTRACTOR Stickle Drlg.


Wildcat

330 _____ Ft. from N. Line

_____ Ft. from S. Line

330 _____ Ft. from E. Line

_____ Ft. from W. Line

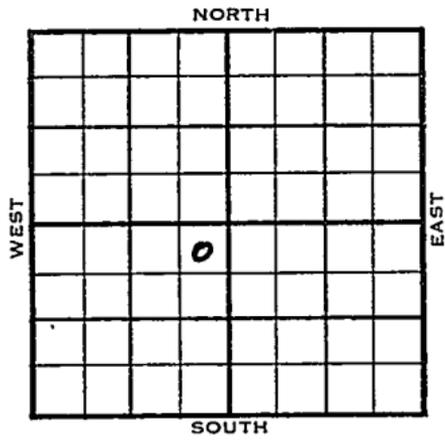

of SW/4

NE NE SW Stanolind-DHM -\$7500.00

	ELEVATION	REPORT
1955	2117'	(WH5-EX15)
DHC Ltr 10/24	Projected Arbuckle @ 4450'	Comm. by 12-15-55
10/25	Location - RURT	Comp. by 2-15-56 (DR #208)
10/26	TD 304'. WOC - 8-5/8" @ 302'	Spudded 10-24-55
10/27	TD 304'. WOC - 8-5/8" csg.	(F.R.)
10/28	Drlg. 1645'	
10/31	Drlg. 2320'	
11/1	Drlg. 3290'	
11/2	Drlg. 3550'	
11/3	Drlg. 3705'	
11/4	Drlg. 3820'	
11/7	Drlg. 3945'	
	Drlg. 4208'	
	DST #1, 4068-90', 1 hr, rec 255'	
	mud cut salt wtr. FP 120#. BHP 1210#.	
11/8	Drlg. 4315'	
11/9	Drlg. 4420'	
11/10	TD 4480'. Prep to P & A. Ran EL	
11/11	TD 4480'. Plugged & Abandoned 11-10-55	
11/16	Comm. 10-24-55	
	8" @ 302/275 DST 4068-90 open 1 hr.	
	rec 255' MSW. 1210#. TD 4480' D & A	
	Anh. 1345', Tp 3328', H. 3565', L.	
	3605', BKC 3906', sh 4045', Ce 4074'	
	Cg 41028, K. 4113', V. 4172'	
	TD 4480'. D & A	ABANDONED

1955
11/25

Advised Contract Section-D & A.

County Butch Elev. _____
 Sec. 5 Twp. 18 Rge. 20W
 Company Sunray Mid-Continent
 FarmName Chess Irvin No. 1

TOPS	DEPTH	LOG	DATUM
Anh.			
Tr.			
H.			
Tr.			
Dg.			
Bl.			
L.			
K.C.			
B.K.C.			
Ce.			
C.			
M.			
M.			
K.			
Mz.			
Mq.			
V.			
S.			
S.			
A.			
R.			
PE.			
G.			
T.P.			

Loc. in Sec. NE NE SW
 Geol. _____
 Contr. _____
Stickle
 Pool _____
Wildcat

FIRST REPORT
 OCT 26 '55

Date Comm. 10-21-55 Stanolind - DHM
8th @ 302/275 WOC

(Large handwritten mark, possibly 'W' or 'D', with a diagonal slash through it)

County Rush Elev. 2117
 Sec. 5 Twp. 18 Rge. 20W
 Company Sunray Mid-Continent
 Farm Name Chess Irvin No. 1

TOPS	DEPTH	LOG	DATUM	Loc. in Sec.
Anh.	1345			NE NE SW
Tr.	3328			
H.	3565	3563	1446	
Tr.		3582	1465	
Dg.				
Bl.				
L.	3605	3609	1492	Geol.
K.C.		3948	1831	
B.K.C.	3916			Contr.
Ce. <u>sh</u>	4045	4043	1926	
Ce. <u>sd</u>	4074	4078	1961	Stickle
M.		4172	2055	Pool
K. <u>ca</u>	4102		1985	
K. <u>f</u>	4143	4207	2090	Wildcat
Mz.				
Mo.				
V.	4172	4246	2129	<div style="border: 1px solid black; padding: 5px; display: inline-block;"> ABANDONED 0 </div>
S.		4389	2272	
A.		4396	2279	
R.				
Pe.				
G.				
T.D.	4480			

Date Comm. 10-24-55 NOV 16 1955
 8" @ 302/275 DST 4068-90 open 1 hr.

rec. 255' msw 1210#

D & A