

Rush

KANSAS

DX 78-1

Section 17 Township 18 Range 20 W

Well No. #1 M. Jones

Company Petroleum Inc.

NORTH

14

	0						

WEST

EAST

SOUTH

Rush

SEC.	TWP.	R.
17	18	20W

WELL NO.

#1 M. Jones FARM
COMPANY

Petroleum Inc.

CONTRACTOR

Garvey


Wildcat

_____ Ft. from N. Line

_____ Ft. from S. Line

_____ Ft. from E. Line

_____ Ft. from W. Line

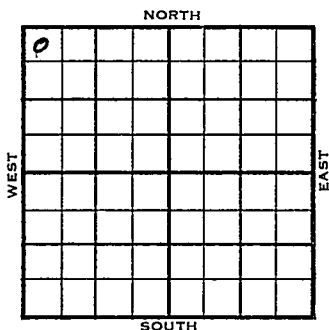

NW NW NW
 $\frac{1}{2}$ Mi SDX

Stanolind-DHM

1955	ELEVATION	REPORT
	2133'	

8/17 Comm 8/15/55
8" @257/175 WOC

8-25 Anhy 1385, Heeb. 3619, Lans. 3664,
Drlg. 3770

9-2 Lans. 3664, Ce. 4141, Ce.sd. 4157,
Miss. 4223
DST 4133-57, open 1 hr., rec. 30' mud,
1200/20"
DST 4162-70, open 1 hr., rec. 30' mud,
1150/20",
DST 4171-85, open 1 hr., rec 250' mw,
1150/20",
Drlg. 4298

9-7 D & A

TOPS	DEPTH	LOG
Anh.	1385	1393
H.	3619	3619
Tr.		3640
L.	3664	3662
Ce		4106
Sh	4141	4144
Sd	4157	
M.	4223	4222
K.		4298
Osage		4254
V	4393	4373
S.	4553	4521
A	4572	4535

DX-78

T.D. 4605'

ABANDONED

County Rush Elev. _____
 Sec. 17 Twp. 18 Rge. 20W
 Company Petroleum Inc.
 Farm Name M. Jones No. 1

TOPS	DEPTH	LOG	DATUM	Loc. in Sec.
Anh.				NW NW NW
Tr.				
Dg.				
Bl.				
L.				Geol.
K.C.				Contr.
B.K.G.				
Ce.				<u>Garvey</u>
C.				Pool
M.				<u>Wildcat</u>
K.				
Mz.				
Mq.				
V.				
S.				
S.				
A				
R.				
PE.				
G.				
T.D.				

0
 AUG 17 '55
 FIRST REPORT
 1/2 mile

Date Comm. 8-15-55 Stanolind - DHM
8" @ 257/175 WOC

19

Co.

Lse.

No.

Sec.

T.

R.

County Rush Elev. 2133
 Sec. 17 Twp. 18 Rge. 20W
 Company Petroleum Inc.
 FarmName M. Jones No. 1


	TOPS	DEPTH	LOG	DATUM
Anh.		1385	1393	
Tr.				
H.		3619	3619	1489
Dg.			3640	1507
Bl.				
L.		3664	3662	1529
K.C.				
B.F.G.	Ce		4106	1973
Ce.	Sh	4141	4144	2011
Ce.	Sd	4157		2024
M.		4223	4222	2089
K.			4298	2165
Mz.	(Range)		4254	2121
Mq.				
V.		4393	4393	2240
S.		4553	4521	2388
S.				
A.		4572	4535	2402
R.				
PE.				
G.				
T.D.		4605		

Loc. in Sec. NW NWNW

Geol. _____

Contr. Garvey

Pool Wild cat

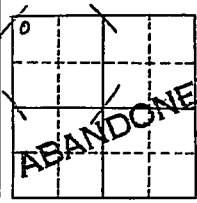

Date Comm. 8-15-55 SEP 7 1955
8" @ 257/175 DST 1133-57 open 1 hr.
Rec. 30' mud 1200/20" DST 4162-70
open 1 hr. Rec. 30' mud 1150/20"
DST 1171-85 open 1 hr. Rec. 250' mw
1150/20"

D & A

Co.
No.
Sec.
T.
R.