DX 78-1

Rush

KANSAS

Section 26 Township 18 Range 20W

Well No. #1 Fitzler

Company Bennett & Roberts.

15

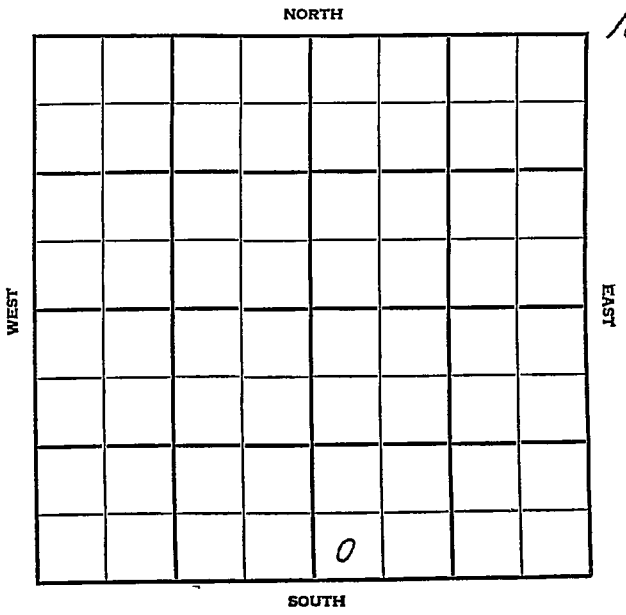

Rush KANSAS

SEC.	TWP.	R.
26	18	20 W

WELL NO.

1 Fitzler FARM

COMPANY

Bennett & Roberts

CONTRACTOR

B & R Drlg.

Wildcat

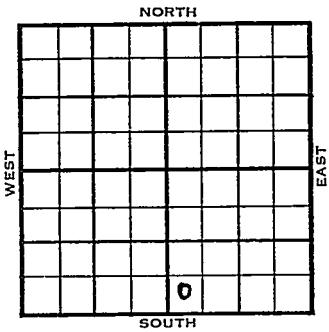

_____ Ft. from N. Line

330 Ft. from S. Line

_____ Ft. from E. Line

330 Ft. from W. Line

SW SW SE

Aurora-DHM

1955	ELEVATION ~~1749'~~ 2122' REPORT
3/23	Spud 3-17-55 8" @ 270 Drlg. 2875'
~~4/6~~	~~Spud 3-4-55, Oil Well, TD 3287 8" @ 160, Heeb 2745, Br Lime 2871', Lans 2891, Simp 3235 DST 3188-3260 open 1 hr Rec. 240' mud 620# DST 3257-7 70, open 1 hr Rec 285' OCW 650#, 43/3257-65 S/½ BOPH 1½ BW frac S/3 BOPH 4 BW Comp 25 BOPD 25BW~~ error
4/6	Spud 3-17-55, D&A, TD 4376 8" @ 270, Heeb 3608, Lans 3652 BKC 3938, Cherokee 4088, DST 3073-4100 open 1 hr. Rec 1250' SW 1350# DST 4100-12 open 1 hr. Rec 3000' SW 1380# Miss 4118, Misener 4217, Viola 4226, Simp. 4309, Arb 4336 TD 4376 D&A **ABANDONED**

DX-78

FORM 275 FOR SALE BY KANSAS BLUE PRINT CO.

County Rush State Kansas

Sec. 26 (Blk. Twp.) 18 (Sur. Rge.) 20W Map No.

Operator Bennett & Roberts

Well No. 1 Farm Fitzler

Elev. Location SW SW SE

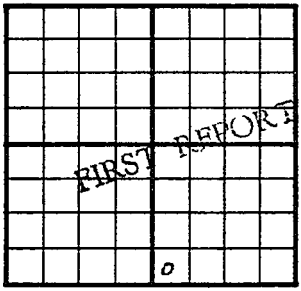

330 Ft. From S Line SE Quarter

1st. Report MAR 23 1955

Completion

Remarks Aurora - DHM

B & R Drlg. - Contr.

Spudding Date 3-17-55

Drlg. Data Wildcat

8" @ 270 drlg. 2875

FABEN GILSTRAP

FORM 275 FOR SALE BY KANSAS BLUE PRINT CO.

County Rush State Kansas

Sec. 26 (Blk.) (Twp.) 18 (Sur.) (Rge.) 20W Map No.

Operator Bennett & Roberts

Well No. 1 Farm Fitzler

Elev. 2122. Location SW SW SE

330 Ft. From S Line SE

330 Ft. From W Line Quarter

1st. Report

Completion APR 6 1955

Remarks Wildcat

B & R Drlg. - Contr.

Spudding Date 3-17-55

Drlg. Data D & A TD 4376

8" @ 270 Heeb. 3608 Lans. 3652

B KC 3938 Cherokee 4088 DST 4073-4100

open 1 hr. Rec. 1250' sw 1350#

DST 4100-12 open 1 hr. Rec. 3000' sw

1380# Miss. 4118 Misener 4217

Viola 4226 Simp. 4309 Arb. 4336

TD 4376

D & A

FABEN GILSTRAP