

KANSAS

O.W.D.D.
Butler county

FORM 51 5M 6-46 PETROL

Section 11 Township 28 Range 6-E

Well No. #2, Lucas

Company Rex and Morris

NORTH

0							

SOUTH

WEST

EAST

KANSAS

Butler County

O.W.D.DSec. 11 Twp. 28 R. 6EWell No. #2 Lucas Farm

Rex & Morris

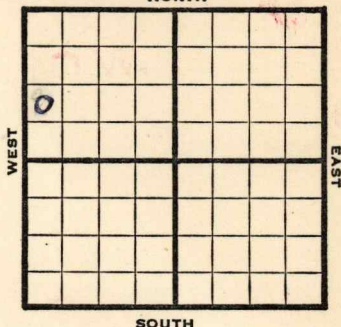
Company

Miscellaneous**Kramer-Stearn Pool**

NORTH

 Ft. from N. Line990 Ft. from S. Line Ft. from E. Line330 Ft. from W. Line

NW SW NW

1946 **Elev. 1386' REPORT**

8/28 Spud

9/5 Drlg 730'

9/10 13" @ 8035'

Drlg 1400'

9/18 8" @ 2170'

Drlg 2200'

9/24 **Miss 2740**

7" @ 2741'

TD 2751 WOC

10/2 **Miss 2740'**

7" @ 2741

TD 2751'

Pump 35 POT

Grav 39.6

COMPLETED**O.W.D.D**

1953

8/26 **Miss 2740'**

7" @ 2741'

OTD 2751'

Simp 3000'

DD 3002'

5" @ 3000'

9/9 Oil Well

TD 3010'

Miss 2740'

7" @ 2741'

OVER

1953

Information brought forward.

9/9

OTD 2751'

CO to 2003'

FU 85' fluid 16 hr.

Arb 3008',

DD 3010'

FU 2650' oil 20 hr.

Comp. 25 bopd.

COMPLETED

KANSAS

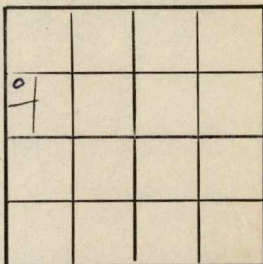
Kansas Pool Name MiscellaneousMap No. 1 Sec. 11 Twp. 28 R. 6EWell No. 2 LucasRex & Morris Company

FIRST REPORT

Contractor

NW SW NW

SECTION PLAT

 Ft. from N. Line990 Ft. from S. Line Ft. from E. Line330 Ft. from W. LineButler CountyLocation Rig up

Drilling and Remarks:

Spud.

RECORD

Cased in., ft.Sand Gas Oil Total Depth

PRODUCTION

1st 24 hrs. Nat. 1st 24 hrs. after shot Gas Cu. Ft.Dry Hole Abandoned

Date

AUG 28 1946 19S. J. LEWIS Scout

Kansas Pool Name MiscellaneousMap No. ~~KANSAS~~ Sec. 11 Twp. 28 R. 6EWell No. 2 LucasRex & Morris

Company

COMPLETED

Contractor

NW SW NW

E 1/4 388
SECTION PLAT Ft. from N. Line990 Ft. from S. Line Ft. from E. Line330 Ft. from W. Line

0			

Butler CountyLocation Rig up

Drilling and Remarks:

Miss 27407' @ 2741Pump 35-2409-6-44**RECORD**Cased in., ft.Sand Gas Oil Total Depth 2251**PRODUCTION**1st 24 hrs. Nat. 1st 24 hrs. after shot Gas Cu. Ft.Dry Hole Abandoned

Date

OCT 2 194619S. J. LEWIS

Scout

Simp. 3000 DD 3002 5" @ 3000

O. W. D. D

County Butler State KansasSec. 11 (Blk.
Twp.) 28 (Sur.
Rge.) 6E Map No. _____Operator Rex & MorrisWell No. 2 Farm LucasElev. 1386 Location NW SW NW

990 Ft. From S Line NW330 Ft. From W Line Quarter

1st. Report _____

Completion SEP 9 1953Remarks OWDD

O. W. D. D

Spudding Date _____

Drlg. Data Oil well TD 3010Miss. 2740 7" @ 2741 OTD 2751Simp. 3000 DD 3002 5" @ 3000CO to 2003 FU 85' fluid 16 hr.Arb. 3008 DD 3010 FU 2650' oil 20 hr.Comp. 25 bopd

J. G. McGEHEE