


KANSAS

Section 11 Township 28 Range 6E

Well No. 5 Lucas

Company Rex & Morris

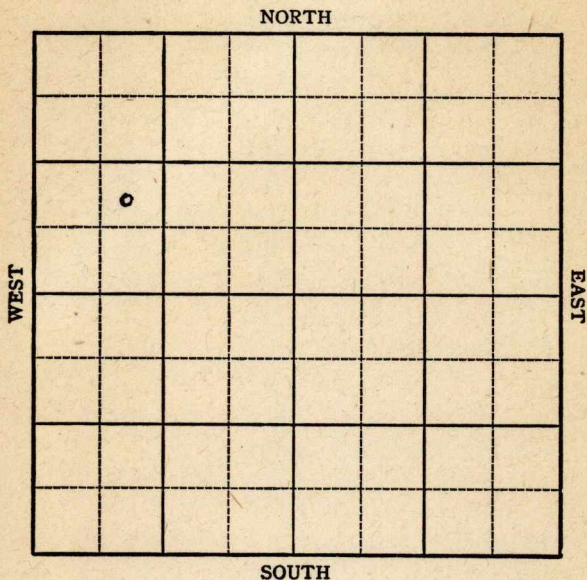

KANSAS

Butler ✓

Sec. 11 Twp. 28 R. 6-E

Well No. #5 Lucas Farm

Rex & Morris Company


Miscellaneous

 Ft. from N. Line

990 Ft. from S. Line

 Ft. from E. Line

990 Ft. from W. Line

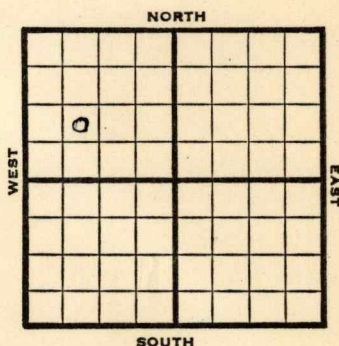

NE SW NW

1947 **Elev. 1396** REPORT

2/26 Location

3/4 Location

3/11 " "

3/18 " "

3/25 Mach

4/2 Drlg. 150

4/9 Drlg. 1075'
13" @ 965'

4/9 Drlg. 1830'

4/23 **Lans 1735**
KC 2060
8" @ 2195
Drlg 2485'

4/30 **Miss 2723**
87" @ 2730
Pump 50 Pot
Grav. 38

COMPLETED

Map No. 11 Sec. 11 Twp. 28 R. 6EWell No. 5 LucasRex & Morris CompanyFIRST REPORT Contractor

NE SW NW

SECTION PLAT

o			

 Ft. from N. Line990 Ft. from S. Line Ft. from E. Line990 Ft. from W. LineButler CountyLocation XRig up

Drilling and Remarks:

RECORD

Cased in., ft.Sand Gas Oil Total Depth

PRODUCTION

1st 24 hrs. Nat. 1st 24 hrs. after shot Gas Cu. Ft.Dry Hole Abandoned

Date

FEB 26 1947 19S. J. LEWIS Scout

Map No. 1511 Sec. 11 Twp. 28 R. 6E

Well No. 5 Lucas

Rex & Morris Company

COMPLETE

Contractor

NE SW NW

E. 1. 1896
SECTION PLAT

 Ft. from N. Line

990 Ft. from S. Line

 Ft. from E. Line

990 Ft. from W. Line

6			

Butler County

Location

Rig up

Drilling and Remarks:

Wais 2728
7" @ 2730
Pump 50 Bbl

382 1/2

RECORD

Cased in., ft.

Sand

Gas

Oil

Total Depth 2738

PRODUCTION

1st 24 hrs. Nat.

1st 24 hrs. after shot

Gas Cu. Ft.

Dry Hole

Abandoned

Date

APR 30 1947 19 S. J. LEWIS Scout