

Butler


FORM 51 IOM 12-46 PETROL

KANSAS

Section 11 Township 28 Range 6E

Well No. 6 Lucas

Company Rex & Morris

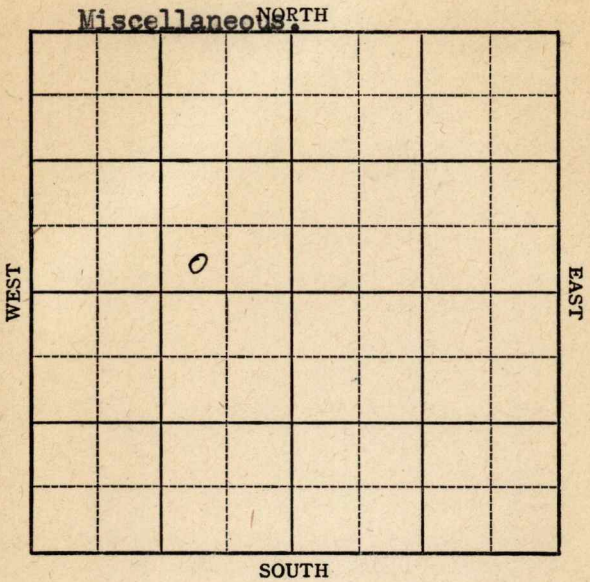

KANSAS

Butler

Sec. 11 Twp. 28 R. 6-E

Well No. #6 Lucas Farm


Rex & Morris Company
Miscellaneous

 Ft. from N. Line

330 Ft. from S. Line

990 Ft. from E. Line

 Ft. from W. Line

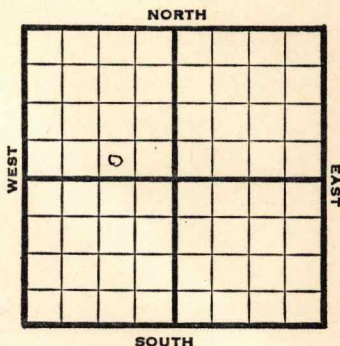

SW SE NW

REPORT

1947 Elev. 1410'

4/30 Machine

5/7 Drlg. 375'

5/13 13" @ 977
Drlg 1175'

5/20 Drlg 1515'

5/27 10" @ 1585'
8" @ 2190
KC 2070
Miss 2741
Drlg. 2790'

6/3 7" @ 3020
Arbuckle 3036
Drlg. 3037'

6/11 Arb. 3036'
7" @ 3020'
Pump 45 Pot
38.0 Gr.
TD 3041'

COMPLETED

Map No. K 11 Sec. 11 Twp. 28 R. 6E

Well No. 6 Lucas

Rex & Morris Company

FIRST REPORT Contractor

SW SE NW

SECTION PLAT

 Ft. from N. Line

330 Ft. from S. Line

990 Ft. from E. Line

 Ft. from W. Line

Butler County

Location

Rig up

Drilling and Remarks:

Machine

RECORD

Cased in., ft.

Sand

Gas

Oil

Total Depth

PRODUCTION

1st 24 hrs. Nat.

1st 24 hrs. after shot

Gas Cu. Ft.

Dry Hole

Abandoned

Date

APR 30 1947 19

S. J. LEWIS Scout

Map No. 11 Sec. 11 Twp. 28 R. 6E

Well No. 6 Lucas

Rex & Morris Company

COMPLETE Contractor

SW SE NW

E 1/4 10
SECTION PLAT

 Ft. from N. Line

330 Ft. from S. Line

990 Ft. from E. Line

 Ft. from W. Line

	6		

Butler County

Location

Rig up

Drilling and Remarks:

CR 7 3036
2" C 3036
Page 45 BT

35-42

RECORD

Cased in., ft.

Sand

Gas

Oil

Total Depth 3041

PRODUCTION

1st 24 hrs. Nat.

1st 24 hrs. after shot

Gas Cu. Ft.

Dry Hole

Abandoned

Date

JUN 1 1 1947 19 S. J. LEWIS Scout