


Map No. **KANSAS** Sec. **14** Twp. **32** R. **2E**

Well No. **13 - Emerich** Farm

~~**Rotana Ref**~~ Company

(Emerich) NORTH **Shell Ref**

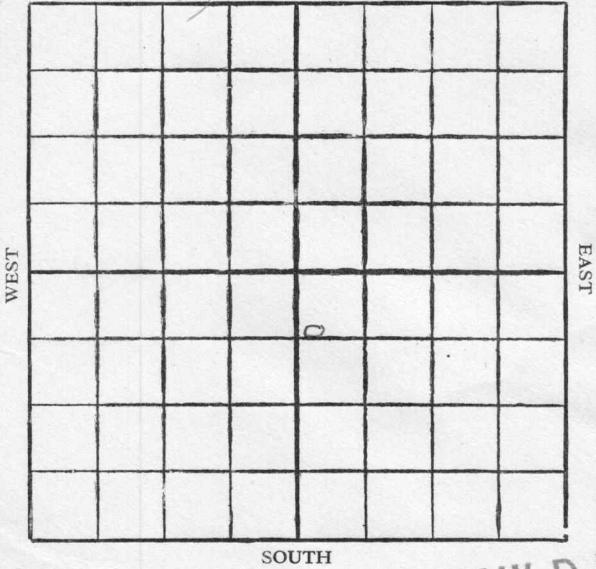

O. W. D. D

Location

Rig Up.....

Drilling Remarks

Drilling Remarks

.....

.....

RECORD

PRODUCTION

Cased..... in. ft.

1st 24 hrs. Nat.....

Sand

1st 24 hrs. after shot.....

Gas

Gas..... cu. ft.

Oil

Dry Hole.....

Total Depth.....

Abandoned.....

Map No. KANSAS Sec. 14 Twp. 32 R. 2 E


Well No. 13 - Emerich Farm
~~Kansas Pet Corp~~ Company
Shell Pet

601 Ft. from N. Line

_____ Ft. from S. Line

_____ Ft. from E. Line

215 Ft. from W. Line

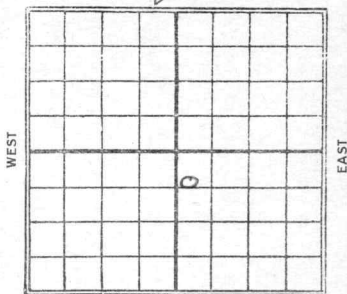

O. W. D. D

1928

Date REPORT

5/31 ROG
 6/6 Rigging up -
 6/13 Drly 410
 6/20 " 1320
 6/27 " 1430
 7/3 Sand 1936 - T.D. 2062
400' oil in hole -
 7/11 Top sd. 1936 T.D. 2065
swabbing 101 bbl
24 hrs

O. W. D. D

1935
 9/20 w/r 10" OT 7 2065
 10/3 _____
 10/19 CO 1958
 11/4 TD 2040 fcy
 11/7 - 11/14 - 11/21 - 11/29 -
 12/6 Set whipstock
 12/13 slg 1932
 12/19 slg on tools 1958
 12/24 _____
 12/36 8" 1919 TD 2065
 1/10 Reaming 8"

OVER

1/17 dly 2045

1/24 dly 2089 6" 2020

1/31 " 2412

2/7 Top Solo 2815

TD 2817 Ring 7"

2/14 5" 2817 TD 2883

flowed 1988 bbls oil & 14
bbls wtr 24 hrs.

2/18 Dolomite 2815

TD 2883

PB 2863

1809 bbls.

COMPLETED

Map No. KANSAS Sec. 14 Twp. 32 R. 27

Well No. 13 Emerich

Roxana P. & C. Corp. Company

Contractor

SECTION PLAT

601 Ft. from N. Line

----- Ft. from S. Line

----- Ft. from E. Line

215 Ft. from W. Line

		o	

FIRST REPORTS

Location -----

Rig up -----

Drilling and Remarks:

ROG

RECORD

Cased ----- in., ----- ft.

Sand -----

Gas -----

Oil -----

Total Depth -----

PRODUCTION

1st 24 hrs. Nat. -----

1st 24 hrs. after shot -----

Gas ----- Cu. Ft.

Dry Hole -----

Abandoned -----

Date

MAY 31 1928

S. J. LEWIS

Scout

Map No. **K1 KANSAS** Sec. 14 Twp. 32 R. 2E

Well No. 13 Emerick

Roxana P & Corp Company

Contractor

SECTION PLAT

601 Ft. from N. Line

_____ Ft. from S. Line

_____ Ft. from E. Line

215 Ft. from W. Line

		0	

COMPLETED

Location _____

Rig up _____

Drilling and Remarks:

Top Sand 1936

Total Depth

2065

Swabbing

101 & 1/2 hrs

RECORD

Cased _____ in., _____ ft.

Sand _____

Gas _____

Oil _____

Total Depth _____

PRODUCTION

1st 24 hrs. Nat. _____

1st 24 hrs. after shot _____

Gas _____ Cu. Ft.

Dry Hole _____

Abandoned _____

Date

JUL 11 1928

192

S. J. LEWIS

Scout

Map No. 1 Sec. 14 Twp. 32 R. 23

Well No. 13-Emrick

Shell Company

Contractor

FIRST REPORTS

SECTION PLAT

		0	

601 Ft. from N. Line

..... Ft. from S. Line

..... Ft. from E. Line

215 Ft. from W. Line

Cwdd

Location.....

Rig up.....

Drilling and Remarks:

OTD 2065

NR 10"

RECORD

Cased.....in.,ft.

Sand.....

Gas.....

Oil.....

Total Depth.....

PRODUCTION

1st 24 hrs. Nat.....

1st 24 hrs. after shot.....

Gas.....Cu. Ft.

Dry Hole.....

Abandoned.....

Date

9-20-35 192.....

ORVAL MANNSCHRECK

Scout

Map No. 1 Sec. 14 Twp. 32 R. 2 E

Well No. 13-Emrich

Shell Petroleum Company
Contractor

COMPLETE SECTION PLAT

601 Ft. from N. Line

..... Ft. from S. Line

..... Ft. from E. Line

215 Ft. from W. Line

		0	

Location.....

Rig up.....

Drilling and Remarks:

P.B. 2863

1809 bbls

RECORD

Cased..... in., ft.

Sand Dolomite 2815

Gas.....

Oil.....

Total Depth 2883

PRODUCTION

1st 24 hrs. Nat.....

1st 24 hrs. after shot.....

Gas..... Cu. Ft.

Dry Hole.....

Abandoned.....

Date

2-19-36 192

ORVAL MANNSCHRECK Scout