


Section 11 Township 28 Range 6E

Well No. 2/8 Lucas "B"

Company Rex & Morris et al

Misc.

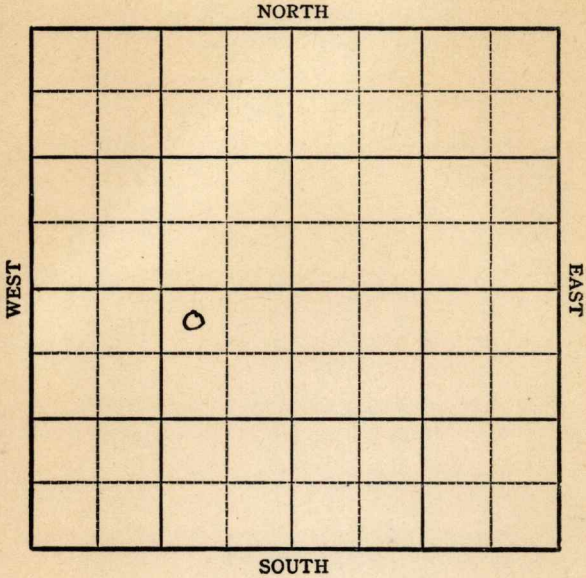

KANSAS

Butler

Sec. 11 Twp. 28 R. 6E ✓

Well No. S Lucas #2 Lucas "B" Farm

Rex & Morris et al Company


Misc.

330 Ft. from N. Line

_____ Ft. from S. Line

990 Ft. from E. Line

_____ Ft. from W. Line

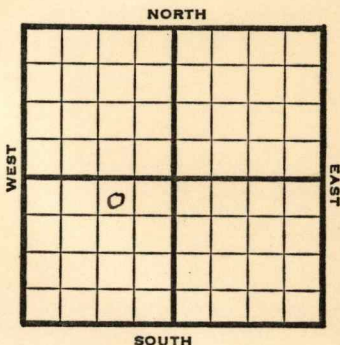

NW NE SW

1948 **Elev. 1392'** REPORT

- 9/22 Location
- 9/29 Surface hole
- 10/6 Drlg. 795'
- 10/13 13" @ 860'
10" @ 1485'
Drlg. 1925'
- 10/19 8" @ 2170'
Drlg.. 2430'
- 10/26 **Arbuckle 3029'**
TD 3036'
5" @ 3009'
- 11/3 **Arbuckle 3029'**
5" @ 3009'
500 acid
Pump 45 oil Pot.
Gr. 38°
TD 3036'

COMPLETED

Map No. 11 Sec. 11 Twp. 28 R. 6E

Well No. 2 Lucas "B"

Rex & Morris etal. Company

COMPLETE

Contractor

NW NE SW

E. 1. 1392

SECTION PLAT

330

Ft. from N. Line

Ft. from S. Line

990

Ft. from E. Line

Ft. from W. Line

	0		

Butler County

RECORD

Location _____

Cased _____ in., _____ ft.

Rig up _____

Sand _____

Drilling and Remarks:

Gas _____

Oil _____

Total Depth 3026

PRODUCTION

1st 24 hrs. Nat. _____

1st 24 hrs. after shot _____

Gas _____ Cu. Ft.

Dry Hole _____

Abandoned _____

Per 3029
5" @ 3009
500 acid
Pump 4500 (P)
280-84

Date

NOV 3 1948 19

S. J. LEWIS Scout

Map No. 11 Sec. 11 Twp. 28 R. 6E

Well No. 2 Lucas "B"

Rex & Morris etal. Company

CORRECTION Contractor

NW NE SW

SECTION PLAT

330 Ft. from N. Line
 _____ Ft. from S. Line
990 Ft. from E. Line
 _____ Ft. from W. Line

	o		

Butler County

Location _____
 Rig up _____
 Drilling and Remarks:

Reported as
 #8 Lucas

RECORD

Cased _____ in., _____ ft.
 Sand _____
 Gas _____
 Oil _____
 Total Depth _____

PRODUCTION

1st 24 hrs. Nat. _____
 1st 24 hrs. after shot _____
 Gas _____ Cu. Ft.
 Dry Hole _____
 Abandoned _____

Date

OCT 13 1948

19

S. J. LEWIS

Scout