


Map No. _____ Sec. *14* Twp. *32* R. *2E*

Well No. *4 - Emerick* Farm
~~*Ryan Det Corp*~~ Company
Shell Pit

_____ Ft. from N. Line
1007
~~*1100*~~ Ft. from S. Line
_____ Ft. from E. Line
200
~~*220*~~ Ft. from W. Line

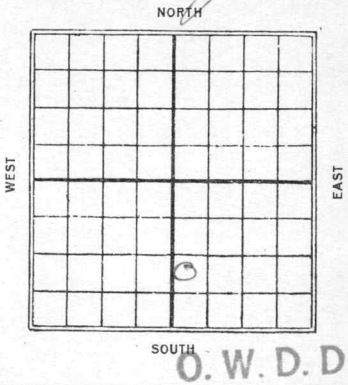

1927

Date	REPORT
<i>11/2</i>	<i>Rig Bldg.</i>
<i>11/9</i>	<i>Drly 300</i>
<i>11/16</i>	<i>Line 1200-14 - 450' oil in hole drilling 1282-</i>
<i>11/22</i>	<i>" 1565</i>
<i>11/29</i>	<i>Top Sand 1994 - oil 2038-T.D. 2095 filled up + flowed in 3 hrs - caught fire - rig burned.</i>
<i>12/7</i>	<i>Top Sand 1944 - T.D. 2105 - no test</i>
<i>12/14</i>	<i>T.S. 1994 - T.D. 2105 140 gts / 2034 - 2104 3250 bbls 24 hrs</i>
<i>1935</i>	<i>O.W.D.D</i>
<i>9/20</i>	<i>Rgn Rotary</i>
<i>10/3</i>	<i>Alomite 2860-66 Rim 7"</i>
<i>10/10</i>	<i>2908 TD H.F.O.</i>
<i>10/24</i>	<i>Sol. 2860 TD 2908 4000 v 8000 acid 1150 oil 27 water.</i>

COMPLETED

Map No. **KANSAS** Sec. 14 Twp. 32 R. 2E

Well No. 4 Emerich

Roxana P. & J. Corp. Company

Contractor

SECTION PLAT

		o	

----- Ft. from N. Line

1100 Ft. from S. Line

----- Ft. from E. Line

220 Ft. from W. Line

FIRST REPORTS

Location -----

Rig up -----

Drilling and Remarks:

Rig Bltg

RECORD

Cased ----- in., ----- ft.

Sand -----

Gas -----

Oil -----

Total Depth -----

PRODUCTION

1st 24 hrs. Nat. -----

1st 24 hrs. after shot -----

Gas ----- Cu. Ft.

Dry Hole -----

Abandoned -----

Date

NOV 2 1927

----- 192

S. J. LEWIS

Scout

Map No. KANSAS Sec. 14 Twp. 32 R. 27

Well No. 4 Emeric

Roxana P. & C. Corp. Company

Contractor

SECTION PLAT

		0	

----- Ft. from N. Line

1100 Ft. from S. Line

----- Ft. from E. Line

220 Ft. from W. Line

COMPLETED

Location -----

Rig up -----

Drilling and Remarks:

T.B. 1994 T 112105

140/2034-2104

3250 ft to 24 hrs

RECORD

Cased ----- in., ----- ft.

Sand -----

Gas -----

Oil -----

Total Depth -----

PRODUCTION

1st 24 hrs. Nat. -----

1st 24 hrs. after shot -----

Gas ----- Cu. Ft.

Dry Hole -----

Abandoned -----

Date

DEC 14 1927

S. J. LEWIS

Scout

192

KANSAS

Map No. 1 Sec. 14 Twp. 32 R. 2 E

Well No. 4-Emrick

Shell pet Company

Contractor

FIRST REPORTS

SECTION PLAT

..... Ft. from N. Line

1007 Ft. from S. Line

..... Ft. from E. Line

200 Ft. from W. Line

		0	

Orval

Location.....

Rig up.....

Drilling and Remarks:

OTL 2104

Regn Rotary

RECORD

Cased.....in.,ft.

Sand.....

Gas.....

Oil.....

Total Depth.....

PRODUCTION

1st 24 hrs. Nat.....

1st 24 hrs. after shot.....

Gas..... Cu. Ft.

Day Hole.....

Abandoned.....

**CORRECTION
FEET MEASUREMENTS**

Date

9-20-35 192.....

ORVAL MANNSCHRECK

Scout

Map No. 1 Sec. 14 Twp. 32 R. 2E

Well No. 4-Emrich

Shell pit

Company

Contractor

COMPLETED

SECTION PLAT

		0	

Ft. from N. Line

1007 Ft. from S. Line

Ft. from E. Line

200 Ft. from W. Line

swdd

Location

Rig up

Drilling and Remarks:

4000 and 8000 and

1150 oil 27 water

RECORD

Cased in., ft.

Sand 2860

Gas

Oil

Total Depth 2908

PRODUCTION

1st 24 hrs. Nat.

1st 24 hrs. after shot

Gas Cu. Ft.

Dry Hole

Abandoned

Date

10-24-35

192

ORVAL MANNSCHRECK

Scout