


Map No. _____ Sec. 14 Twp. 32 R. 2E

Well No. 5 - Emerick Farm

~~Wagoner Petroleum~~ Company

Shell Oil

NORTH

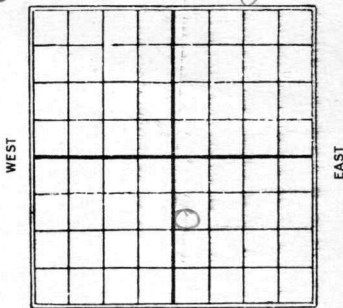

1002 Ft. from N. Line

_____ Ft. from S. Line

_____ Ft. from E. Line

212 Ft. from W. Line

1927

Date _____ REPORT O. W. D. D

<u>11/16</u>	<u>T.O.G.</u>
<u>11/22</u>	<u>Rig</u>
<u>11/29</u>	<u>_____</u>
<u>12/7</u>	<u>Spud</u>
<u>12/14</u>	<u>Drly 365.</u>
<u>12/21</u>	<u>" 980</u>
<u>12/28</u>	<u>" 1345</u>
<u>1928</u>	
<u>1/4</u>	<u>Drly 1770'</u>
<u>1/11</u>	<u>Sand 1960 - drly 2095 -</u> <u>hole full oil -</u>
<u>1/18</u>	<u>T.S. 1960 T.D. 2095</u> <u>P.B. 2089</u> <u>210/1981-2089</u> <u>805 bbls 18 hrs</u>
<u>1935</u>	<u>O.W.D.D</u>
<u>9/20</u>	<u>Drly 2323</u>
<u>10/3</u>	<u>drly. 2828-31 Railing</u>
<u>10/10</u>	<u>2906 TD 1262 bbls 24 hrs.</u>
<u>10/30</u>	<u>drly 2828 TD 2906</u> <u>4000 & 8000 acid</u> <u>2966 bbls.</u>

COMPLETED

Map No. KANSAS Sec. 14 Twp. 32 R. 2E

Well No. 5 Emerick

Roxana P.D. Corp. Company

Contractor

SECTION PLAT

1002 Ft. from N. Line

----- Ft. from S. Line

----- Ft. from E. Line

212 Ft. from W. Line

		0	

FIRST REPORTS

Location -----

Rig up -----

Drilling and Remarks:

ROY

RECORD

Cased ----- in., ----- ft.

Sand -----

Gas -----

Oil -----

Total Depth -----

PRODUCTION

1st 24 hrs. Nat. -----

1st 24 hrs. after shot -----

Gas ----- Cu. Ft.

Dry Hole -----

Abandoned -----

Date

NOV 16 1927

S. J. LEWIS

192

Scout

Map No. **KANSAS** Sec. 14 Twp. 32 R. 2E

Well No. S. Emerick

Roxana P. & Co. Company

Contractor

SECTION PLAT

		0	

1002 Ft. from N. Line

----- Ft. from S. Line

----- Ft. from E. Line

212 Ft. from W. Line

COMPLETED

Location -----

Rig up -----

Drilling and Remarks:

7/8. 1960
7/11 2095
P.B. 2089
210/1981-2089
8058/6 18 hrs

RECORD

Cased ----- in., ----- ft.

Sand -----

Gas -----

Oil -----

Total Depth -----

PRODUCTION

1st 24 hrs. Nat. -----

1st 24 hrs. after shot -----

Gas ----- Cu. Ft.

Dry Hole -----

Abandoned -----

Date

JAN 18 1928

192

S. J. LEWIS

Scout

Map No. 1 Sec. 14 Twp. 32 R. 23

Well No. 5-Emrick

Shell Company

Contractor

FIRST REPORTS

SECTION PLAT

100 Ft. from N. Line

..... Ft. from S. Line

..... Ft. from E. Line

212 Ft. from W. Line

		0	

Qudd

Location.....

Rig up.....

Drilling and Remarks:

OT 2095

De 92323

RECORD

Cased.....in.,ft.

Sand.....

Gas.....

Oil.....

Total Depth.....

PRODUCTION

1st 24 hrs. Nat.....

1st 24 hrs. after shot.....

Gas.....Cu. Ft.

Dry Hole.....

Abandoned.....

Date

9-20-35 192.....

ORVAL MANNSCHRECK

Scout

Map No. 1 Sec. 14 Twp. 32 R. 2E

Well No. 5-Emrich

Shell pit Company

Contractor

SECTION PLAT

COMPLETED

100 Ft. from N. Line

..... Ft. from S. Line

..... Ft. from E. Line

212 Ft. from W. Line

		0	

Location.....

Rig up.....

Drilling and Remarks;

4000 and
8000 and

2966 ft

RECORD

Cased..... in., ft.

Sand 100 2828

Gas.....

Oil.....

Total Depth 2906

PRODUCTION

1st 24 hrs. Nat.....

1st 24 hrs. after shot.....

Gas..... Cu. Ft.

Dry Hole.....

Abandoned.....

Date

ORVAL MANNSCHRECK

10-30-35 192.....

Scout