


KANSAS

Butler county

Section 11 Township 28 Range 6-E

Well No. #3 ~~#2~~, Lucas

Company Rex and Morris

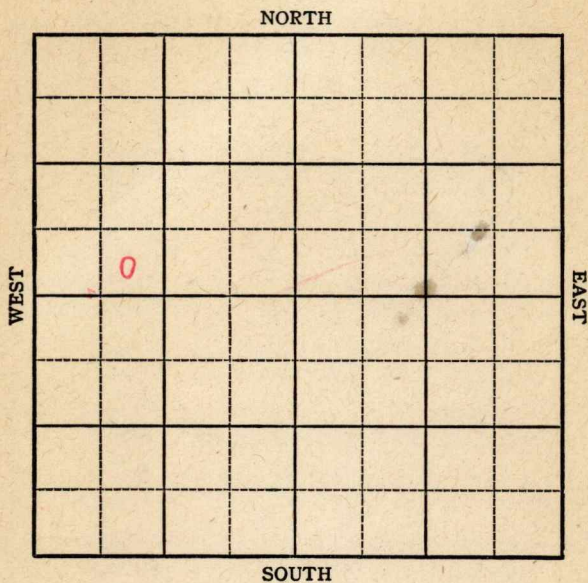

Sec. 11 Twp. 28 R. 6-E

Well No. #3, Lucas Farm

Rex and Morris Company


Miscellaneous

 Ft. from N. Line

330' Ft. from S. Line

 Ft. from E. Line

990' Ft. from W. Line

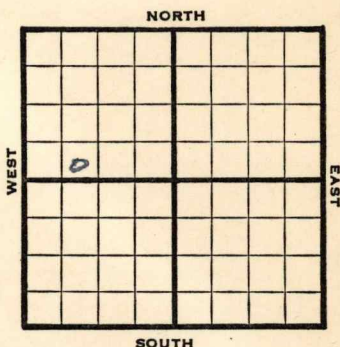

SE SW NW

1946

REPORT

12/4 Machine

12/10 Drlg 350'

12/17 13" @ 979'
Drlg 1345'

1947

1/4 10" @ 1580'
8" @ 2193

Miss 2739'

7" @ 2742-44 TD

1/8 Simp sd 3023-31 TD
2000' oil, Run 5"

1/15 TD 3037'
209 to 3027-34-2000 oil

1/22 Simp 3023'

5" @ 3023'

TD 3037'

Pump 25 POT

38 Grav.

COMPLETED

Kansas

Map No. 11 Sec. 11 Twp. 28 R. 6EWell No. 3 LucasRex & Morris

Company

FIRST REPORT

Contractor

SE SW NW

SECTION PLAT

0			

Ft. from N. Line330Ft. from S. LineFt. from E. Line990Ft. from W. LineButler County

Location

Rig up

Drilling and Remarks:

Machine

RECORD

Cased _____ in., _____ ft.

Sand _____

Gas _____

Oil _____

Total Depth _____

PRODUCTION

1st 24 hrs. Nat. _____

1st 24 hrs. after shot _____

Gas _____ Cu. Ft.

Dry Hole _____

Abandoned _____

Date

DEC 4 1946 19

S. J. LEWIS

Scout

KANSAS

Map No. 11 Sec. 11 Twp. 28 R. 6E

Well No. 3 Lucas

Rex & Morris

Company

COMPLETE

Contractor

SE SW NW

E. 1/4 1/1
SECTION PLAT

 Ft. from N. Line

330 Ft. from S. Line

 Ft. from E. Line

990 Ft. from W. Line

Butler County

Location

Rig up

Drilling and Remarks:

Surf 3023

500 3023

Pump 25 Bx

38-1/2

RECORD

Cased in., ft.

Sand

Gas

Oil

Total Depth 8487

PRODUCTION

1st 24 hrs. Nat.

1st 24 hrs. after shot

Gas Cu. Ft.

Dry Hole

Abandoned

Date

JAN 22 1947 19

S. J. LEWIS

Scout