


Map No. _____ Sec. 14 Twp. 32 R. 2E
 Well No. 7-Emerich Farm _____
Rocana Pet Corp Company _____

NORTH

WEST

EAST

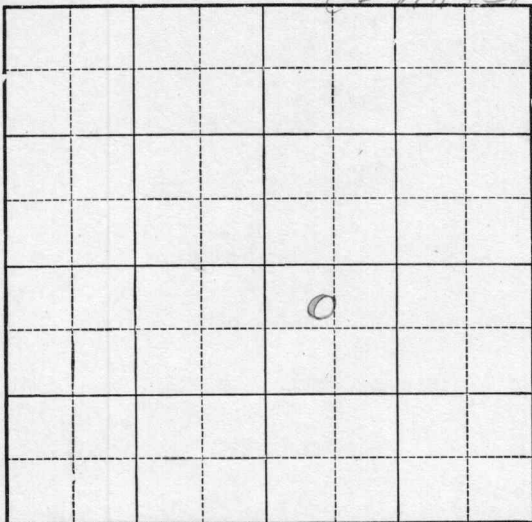

SOUTH

Location _____

Drilling Remarks _____

Rig Up _____

Drilling Remarks _____

RECORD

Cased _____ in. _____ ft.

Sand _____

Gas _____

Oil _____

Total Depth _____

PRODUCTION

1st 24 hrs. Nat. _____

1st 24 hrs. after shot _____

Gas _____ cu. ft.


Dry Hole _____

Abandoned _____

Map No. _____ Sec. 14 Twp. 32 R. 2EWell No. 1-Emerich Farm
Rocana Per Corp Company475 Ft. from N. Line

_____ Ft. from S. Line

_____ Ft. from E. Line

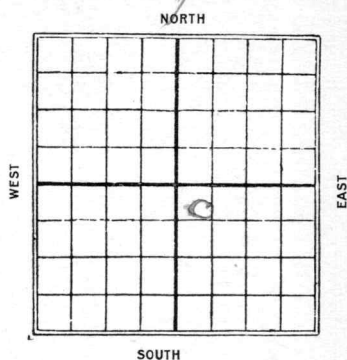639 Ft. from W. Line11/23/27

Date

REPORT

<u>11/23</u>	<u>Rig</u>
<u>11/29</u>	<u>Drill 390-</u>
<u>12/7</u>	<u>" 1352</u>
<u>12/14</u>	<u>" 1740</u>
<u>12/21</u>	<u>Top sand 1991 - T.D. 2096 -</u>
	<u>shot 140 qts. 2022-92 - no test.</u>
<u>12/28</u>	<u>T.S. 1991 - T.D. 2096</u>
	<u>140/2022-2092</u>
	<u>flow & swabbed</u>
	<u>1809 bbls 24 hrs</u>


Map No. **KANSAS** Sec. 14 Twp. 32 R. 27

Well No. 7 Emerich

Roxana P. & Co. Inc. Company

Contractor

SECTION PLAT

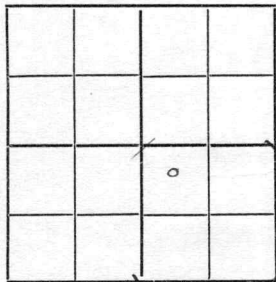

475 Ft. from N. Line

_____ Ft. from S. Line

_____ Ft. from E. Line

639 Ft. from W. Line

FIRST REPORTS

Location _____

Rig up _____

Drilling and Remarks:

Rig

RECORD

Cased _____ in., _____ ft.

Sand _____

Gas _____

Oil _____

Total Depth _____

PRODUCTION

1st 24 hrs. Nat. _____

1st 24 hrs. after shot _____

Gas _____ Cu. Ft.

Dry Hole _____

Abandoned _____

Date

NOV 23 1927

192

S. J. LEWIS

Scout

Map No. **KANSAS** Sec. 14 Twp. 32 R. 2EWell No. 7 EmerichRoxana P & Co. Company


Contractor

SECTION PLAT

475 Ft. from N. Line

Ft. from S. Line

Ft. from E. Line

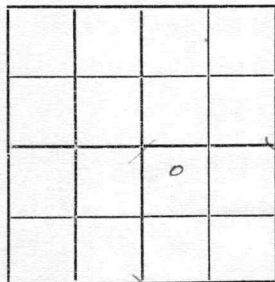639 Ft. from W. Line**COMPLETED**

Location

Rig up

Drilling and Remarks:

T.B. 1991T.D. 2096140/2022-2092Flow & swabbed1809886 24 hrs

RECORD

Cased _____ in., _____ ft.

Sand _____

Gas _____

Oil _____

Total Depth _____

PRODUCTION

1st 24 hrs. Nat. _____

1st 24 hrs. after shot _____

Gas _____ Cu. Ft.

Dry Hole _____

Abandoned _____

Date

DEC 28 1927

S. J. LEWIS

Scout