


KANSAS

FORM 51 IOM 12-46 PETROL

Section 11 Township 28 Range 6-E

Well No. #8 Lucas

Company Rex & Morris etatl.

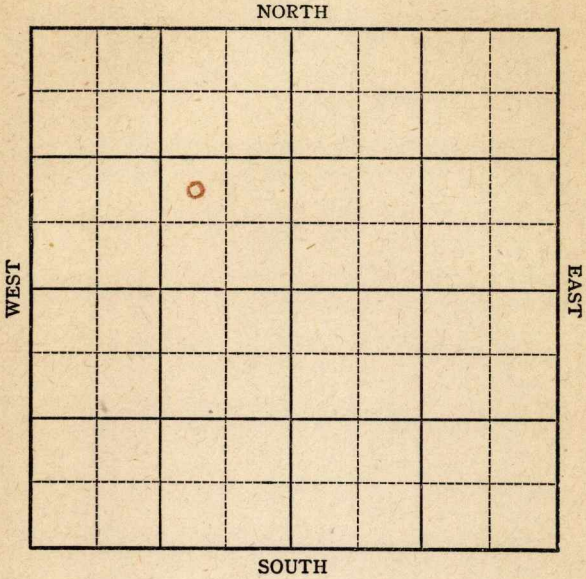

KANSAS

Sec. 11 Twp. 28 R. 6-E

Well No. #7 Lucas Farm

Rex & Morris etal Company

Miscellaneous


_____ Ft. from N. Line

990 Ft. from S. Line

990 Ft. from E. Line

_____ Ft. from W. Line

NW SE NW

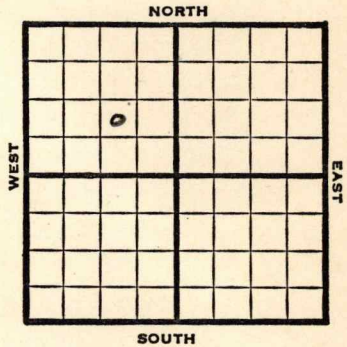

1947 **Elev. 1404'** REPORT

- 6/11 Drlg. 100'
- 6/17 15" @ 970'
Drlg. 1070'
- 6/24 10" @ 1605'
- 7/1 8" @ 2195'
Drlg 2540'
- 7/8 **Wilcox 3018'**
5" @ 3018'
- 7/16 **Arbuckle 3037'**
Drlg 3125'
SWO
- 7/22 Drlg. 3430
- 7/30 **Arb. 3037'**
SWD
TD 3482'

ABANDONED

Map No. 11 Sec. 11 Twp. 28 R. 6E

Well No. 7 Lucas

Rex & Morris etal. Company

CORRECTION

Contractor

NW SE NW

SECTION PLAT

_____ Ft. from N. Line

990 Ft. from S. Line

990 Ft. from E. Line

_____ Ft. from W. Line

	o		

Butler County

Location _____

Rig up _____

Drilling and Remarks:

Reported as
#8 Lucas

RECORD

Cased _____ in., _____ ft.

Sand _____

Gas _____

Oil _____

Total Depth _____

PRODUCTION

1st 24 hrs. Nat. _____

1st 24 hrs. after shot _____

Gas _____ Cu. Ft.

Dry Hole _____

Abandoned _____

Date

JUN 11 1947

19

S. J. LEWIS

Scout

Map No. 11 Sec. 11 Twp. 28 R. 6E

Well No. 7 Lucas

Rex & Morris et al. Company

ABANDONED

Contractor

NW SE NW

E 11404
SECTION PLAT

	5		

_____ Ft. from N. Line

990 Ft. from S. Line

990 Ft. from E. Line

_____ Ft. from W. Line

Butler County

RECORD

Location _____

Cased _____ in., _____ ft.

Rig up _____

Sand _____

Drilling and Remarks:

Gas _____

Oil _____

Total Depth 8452

cut 3037
SWI

PRODUCTION

1st 24 hrs. Nat. _____

1st 24 hrs. after shot _____

Gas _____ Cu. Ft.

Dry Hole _____

Abandoned _____

Date

JUL 30 1947

19

S. J. LEWIS

Scout