

WEST

EAST

C

Abandoned

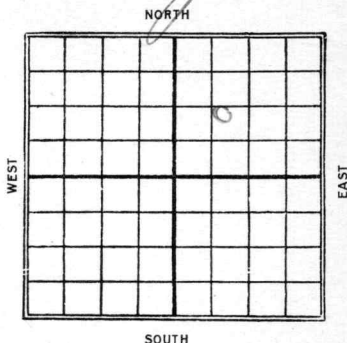
Map No. KANSAS Sec. 14 Twp. 32 R. 2 EWell No. 1-H. Emerich FarmRocana Pet Corp Company

Oxford Townsite

Ft. from N. Line

1198 Ft. from S. Line

Ft. from E. Line

681 Ft. from W. Line1927

Date

REPORT

12/21	Machine
1/18	Spud 285
1928	
1/4	Drillg 706
1/11	" 795
1/18	T.D. 795 - fishing
1/15	Skid rig-
1/31	Spud 105.
2/15	Topeka line 1209-15 3 bbls oil + 5 bbls water -
2/22	Topeka line 1209 to 12.63 7/12 56-63 71 bbls swabbed 24 hrs

Map No. KANSAS Sec. 14 Twp. 32 R. 2E

Well No. 1 H. Emerich

Roxana P. & Co. Corp. Company

Oxford townsite Contractor

SECTION PLAT

		0	

----- Ft. from N. Line

1198 Ft. from S. Line

----- Ft. from E. Line

681 Ft. from W. Line

FIRST REPORTS

Location -----

Rig up -----

Drilling and Remarks:

Twin 2 No 1

Machine

RECORD

Cased ----- in., ----- ft.

Sand -----

Gas -----

Oil -----

Total Depth -----

PRODUCTION

1st 24 hrs. Nat. -----

1st 24 hrs. after shot -----

Gas ----- Cu. Ft.

Dry Hole -----

Abandoned -----

Date

DEC 21 1927

S. J. LEWIS

Scout

Map No. **KANSAS** Sec. 14 Twp. 32 R. 2EWell No. 1-A EmericRoxana P. & Co. Inc. CompanyOxford Transite ContractorTwin No 1

SECTION PLAT

		0	

-----Ft. from N. Line

1198 Ft. from S. Line

-----Ft. from E. Line

687 Ft. from W. Line

COMPLETED

Location -----

Rig up -----

Drilling and Remarks:

Topoka Lime1209 & 12637/1256-637184 1/2 water24 hrs.

RECORD

Cased ----- in., ----- ft.

Sand -----

Gas -----

Oil -----

Total Depth -----

PRODUCTION

1st 24 hrs. Nat. -----

1st 24 hrs. after shot -----

Gas ----- Cu. Ft.

Dry Hole -----

Abandoned -----

Date

FEB 22 1928

192

S. J. LEWIS

Scout

K1 KANSAS

MAP No. _____ SEC. 14 TWP. 32S R. 2E

WELL No. 1 A. E. Emerick

Rorona COMPANY

CONTRACTOR

SECTION PLAT

_____ FT. FROM N. LINE

_____ FT. FROM S. LINE

_____ FT. FROM E. LINE

_____ FT. FROM W. LINE

		0	

no Record

LOCATION _____

RIG UP _____

DRILLING AND REMARKS:

*108' N } #1
+ }
47' E } 9
lost hole*

RECORD

CASED _____ IN. _____ FT.

SAND _____

GAS _____

OIL _____

TOTAL DEPTH 795

PRODUCTION

1ST 24 HRS. NAT. _____

1ST 24 HRS. AFTER SHOT _____

GAS _____ Cu. Ft.

DRY HOLE _____

ABANDONED _____

DATE

1/24 1928 _____ SCOUT