


Map No. KANSAS Sec. 14 Twp. 32 R. 2E
Well No. 2-Gassoway Farm
Gassoway et al Company
Amerinda - North

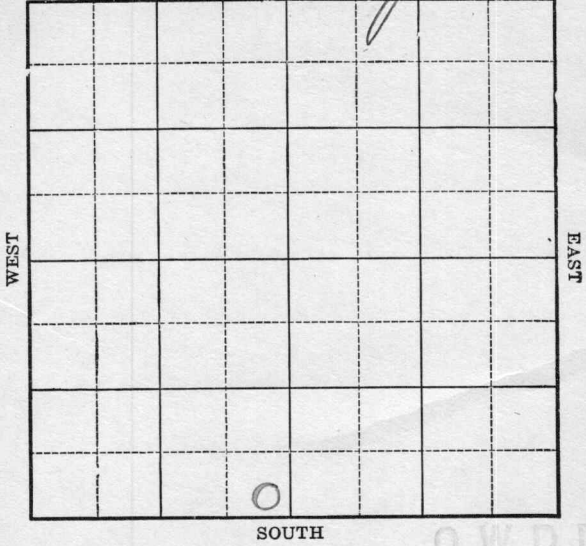

Location _____
Drilling Remarks _____

Rig Up _____
Drilling Remarks _____

RECORD

Cased _____ in. _____ ft.
Sand _____
Gas _____
Oil _____
Total Depth _____

PRODUCTION


1st 24 hrs. Nat. _____
1st 24 hrs. after shot _____
Gas _____ cu. ft.
Dry Hole _____
Abandoned _____

Map No. KANSAS Sec. 14 Twp. 32 R. 2EWell No. 2 - Gassoway FarmWasson et al CompanyAmerala & Murray

Ft. from N. Line

300 Ft. from S. Line200 Ft. from E. Line

Ft. from W. Line

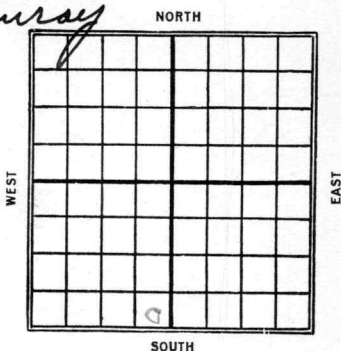1927

Date

REPORT

O.W.D.D

12/7	Pond
12/14	Rig
12/21	Drilg 320
12/28	" 1505
1928	
1/4	Drilg 2012
1/11	Top sand 1997-T.D. 2106
	Shot 160 qts 2033-2105-C.O.
1/18	1400 bbls - will deepew-
1/25	T.S. 1997 T.D. 2127
	160/2023-2105
	1400 bbls 24 hrs
	30/2108-2123
	1158 bbls 14 hrs
1935	O.W.D.D
12/4	B.R.
12/13	20" 41
12/19	Drilg 2150
12/26	Top Layton 2400
	Top 16 C 2422
	Drilg 2775

OVER

1/2/36 Top Solo 2821
7" 2822
TD 2828 dly plugs.

1/8 Salomite 2821
TD 2868
3000 acid
8000 ✓
16, 208 Oil

COMPLETED

Map No. **KANSAS** Sec. 14 Twp. 32 R. 2E

Well No. 2. Gassoway

Gassoway & Co. Company

Contractor

SECTION PLAT

_____ Ft. from N. Line

200 Ft. from S. Line

200 Ft. from E. Line

_____ Ft. from W. Line

FIRST REPORTS

Location _____

Rig up _____

Drilling and Remarks:

Pond

RECORD

Cased _____ in., _____ ft.

Sand _____

Gas _____

Oil _____

Total Depth _____

PRODUCTION

1st 24 hrs. Nat. _____

1st 24 hrs. after shot _____

Gas _____ Cu. Ft.

Dry Hole _____

Abandoned _____

Date

DEC 7 1927

S. J. LEWIS

Scout

Map No. **KANSAS** Sec. 14 Twp. 02 R. 2E

Well No. 2 Garroway

Hasson & Co Company

Contractor

SECTION PLAT

-----Ft. from N. Line

200 Ft. from S. Line

200 Ft. from E. Line

-----Ft. from W. Line

COMPLETED

RECORD

Location -----

Cased ----- in., ----- ft.

Rig up -----

Sand -----

Drilling and Remarks:

Gas -----

T.B. 1997 TII 2127

Oil -----

160/2023-2105

Total Depth -----

1400886 24 hrs

PRODUCTION

30/2108-2123

1st 24 hrs. Nat. -----

1108886 14 hrs

1st 24 hrs. after shot -----

Gas ----- Cu. Ft.

Dry Hole -----

Abandoned -----

Date

JAN 25 1928

S. J. LEWIS

192

Scout

KANSAS

Map No. 1 Sec. 14 Twp. 32 R. 2 EWell No. 2- CassowayAmerada-Sunray Company

Contractor

FIRST REPORTS

SECTION PLAT

Ft. from N. Line

200 Ft. from S. Line200 Ft. from E. Line

Ft. from W. Line

Cwpd

Location

Rig up

Drilling and Remarks:

OTN 2104B.R.

RECORD

Cased _____ in., _____ ft.

Sand _____

Gas _____

Oil _____

Total Depth _____

PRODUCTION

1st 24 hrs. Nat. _____

1st 24 hrs. after shot _____

Gas _____ Cu. Ft.

Dry Hole _____

Abandoned _____

Date

12-4-35 192 _____ Scout

ORVAL MANN-SCHRECK

KANSAS

Map No. 1 Sec. 14 Twp. 32 R. 2E

Well No. 2 Gassoway

Amerada & Shuray Company

Contractor

SECTION PLAT

.....Ft. from N. Line

200 Ft. from S. Line

200 Ft. from E. Line

.....Ft. from W. Line

COMPLETED

OWPD

Location.....

Rig up.....

Drilling and Remarks:

3000 acid
8000 ✓

16,208 oil

RECORD

Cased.....in.,.....ft.

Sand Dolomite 2821

Gas.....

Oil.....

Total Depth 2868

PRODUCTION

1st 24 hrs. Nat.....

1st 24 hrs. after shot.....

Gas.....Cu. Ft.

Dry Hole.....

Abandoned.....

Date

JAN 8 1936

192

ORVAL MANNSCHRECK

Scout