


Map No. _____ Sec. 14 Twp. 32 R. 2E
Well No. 1- Fritz Farm _____
Roxana Pet Corp Company

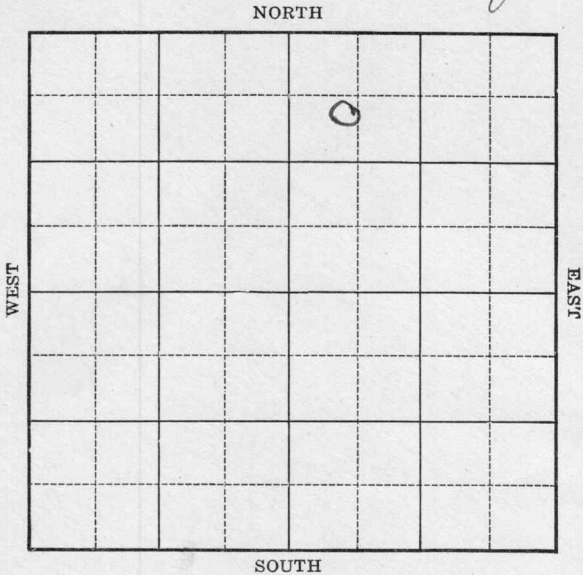

Location _____
Drilling Remarks _____

Rig Up _____
Drilling Remarks _____

RECORD

Cased _____ in. _____ ft.
Sand _____
Gas _____
Oil _____
Total Depth _____

PRODUCTION

1st 24 hrs. Nat. _____
1st 24 hrs. after shot _____
Gas _____ cu. ft.
Dry Hole _____
Abandoned _____

Summer

Map No. _____ Sec. 14 Twp. 32 R. 2EWell No. 1-Fritz Farm _____Rocana Pet Corp Company _____Oxford Limestone980 Ft. from N. Line

_____ Ft. from S. Line

_____ Ft. from E. Line

645 Ft. from W. Line

NORTH

WEST

EAST

SOUTH

1927

Date

REPORT

6/29	Rig
7/6	Drilg 220
7/13	" 588
7/20	" 727
7/27	" 1305
8/3	" 1780
8/10	Top Ad. 2012 - T.D. 2087 - Shot 20 qts 2021 - 41 - 2 failures oil - show water in 3 hrs.
8/17	T.D. 2112 flows 369 bbl nat. 24 hrs
8/24	Flowing 248 bbl -
8/31	Swabbing 198 bbl in 24 hrs -
9/7	T.S. 2012 T.D. 2112 20/2021-2041 Swabbing 198 bbl 24 hrs.


Map No. KANSAS Sec. 14 Twp. 32 R. 2EWell No. 1 FritzRoxana P. & Co. Corp. CompanyOxford Tourisite ContractorCentre Block 88

SECTION PLAT

980 Ft. from N. Line

----- Ft. from S. Line

----- Ft. from E. Line

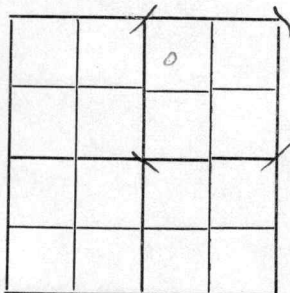645 Ft. from W. Line

FIRST REPORTS

Location -----

Rig up -----

Drilling and Remarks:

Rig

RECORD

Cased ----- in., ----- ft.

Sand -----

Gas -----

Oil -----

Total Depth -----

PRODUCTION

1st 24 hrs. Nat. -----

1st 24 hrs. after shot -----

Gas ----- Cu. Ft.

Dry Hole -----

Abandoned -----

Date

JUN 29 1927

192

S. J. LEWIS

Scout

Map No. **KANSAS** Sec. 14 Twp. 32 R. 2EWell No. 1 FritzRoxana P. & Co. CompanyOxford Limestone ContractorCenter Block 88

SECTION PLAT

		0	

980 Ft. from N. Line

_____ Ft. from S. Line

_____ Ft. from E. Line

645 Ft. from W. Line**COMPLETED**

Location _____

Rig up _____

Drilling and Remarks:

TB 2012TII 211220/2021-2041Swatting 1988 ft24 hrs

RECORD

Cased _____ in., _____ ft.

Sand _____

Gas _____

Oil _____

Total Depth _____

PRODUCTION

1st 24 hrs. Nat. _____

1st 24 hrs. after shot _____

Gas _____ Cu. Ft.

Dry Hole _____

Abandoned _____

Date

SEP 7 1927

S. J. LEWIS

192

Scout