


Map No. KANSAS Sec. 14 Twp. 32 R. 2E
 Well No. J-Gassoway Farm
Gasson et al Company

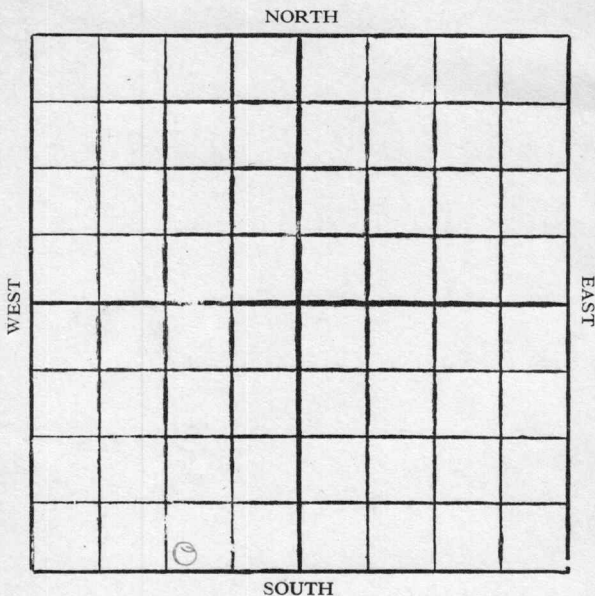

Location

Drilling Remarks

Rig Up.....

Drilling Remarks

RECORD

Cased in. ft.

Sand

Gas

Oil

Total Depth

PRODUCTION

1st 24 hrs. Nat.

1st 24 hrs. after shot

Gas cu. ft.

Dry Hole

Abandoned

KANSAS

Map No. _____ Sec. 14 Twp. S2 R 2EWell No. 7-Gassoway FarmHasson et al Company

NORTH

_____ Ft. from N. Line

220 Ft. from S. Line1160 Ft. from E. Line

_____ Ft. from W. Line

WEST

EAST

SOUTH

1928

Date

REPORT

2/15Rig2/22Drill 2002/29" 12963/7" 18403/14Top Sand 1984 - T.D. 2104
flowed 935 bbls 12 hrs.
while drilling in -3/21T.S. 1984 T.D. 2104160/2011-20991760 bbls 24 hrsair lift

Map No. KANSAS Sec. 14 Twp. 32 R. 2E

Well No. 7 Gasway

Hasson & Co Company

Contractor

SECTION PLAT

_____ Ft. from N. Line
220 Ft. from S. Line
1160 Ft. from E. Line
_____ Ft. from W. Line

FIRST REPORTS

Location _____

Rig up _____

Drilling and Remarks:

Rig

RECORD

Cased _____ in., _____ ft.
Sand _____
Gas _____
Oil _____
Total Depth _____

PRODUCTION

1st 24 hrs. Nat. _____
1st 24 hrs. after shot _____
Gas _____ Cu. Ft.
Dry Hole _____
Abandoned _____

Date

FEB 15 1928

S. J. LEWIS Scout

Map No. KANSAS Sec. 14 Twp. 32 R. 2E

Well No. 7 Gassaway

Hasson & Co Company

Contractor

SECTION PLAT

_____ Ft. from N. Line

220 Ft. from S. Line

1160 Ft. from E. Line

_____ Ft. from W. Line

COMPLETED

Location _____

Rig up _____

Drilling and Remarks:

TB. 1984

TD 2104

160/2011-2099

1760 886 24 hrs

air lift

RECORD

Cased _____ in., _____ ft.

Sand _____

Gas _____

Oil _____

Total Depth _____

PRODUCTION

1st 24 hrs. Nat. _____

1st 24 hrs. after shot _____

Gas _____ Cu. Ft.

Dry Hole _____

Abandoned _____

Date

MAR 21 1928

S. J. LEWIS

Scout