


KANSAS

Map No. _____ Sec. 14 Twp. 32 R. 2EWell No. 9-Bassoway FarmWasson et al Company
AMERADA & SUNBAY OIL NORTH

_____ Ft. from N. Line

270 Ft. from S. Line1050 Ft. from E. Line

_____ Ft. from W. Line

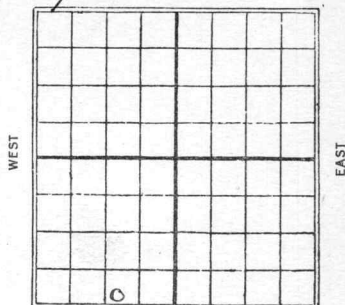1928Twin #7

Date

O. W. D. D

REPORT

KANSAS

4/11 mc
4/18 Drlg 360
4/25 " 915
5/2 " 1410
5/9 Sand 1605-33
Shot 20 qts 1613-27-70 bbls 2 hrs
5/16 Top sand 1605
T.D. 1633 shot 20 qts
1613-27 150 bbls
24 hrs swabbed

1935

O. W. D. D

6/26 Rgn to deeper
7/3 16 R.
7/19 Tonkawa 1984 T7 2047
7/18 10" 951 to 2420
to 2492 KC 2417
king 2825 T7 2830
run 6"
8/1 flow 978 24 hrs T7 2865
8/8 2886 T7 flow 5820
(OVER)

8/14 Simpson 2820
TJ 2886
flow 5820 Bbls.

COMPLETED


Map No. **KANSAS** Sec. 14 Twp. 22 R. 2E

Well No. 9 Gassoway

Masson et al. Company

Contractor

SECTION PLAT

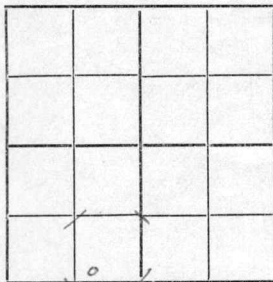

_____ Ft. from N. Line

270 Ft. from S. Line

1050 Ft. from E. Line

_____ Ft. from W. Line

FIRST REPORTS

Location _____

Rig up _____

Drilling and Remarks:

Turn to No 7

MacK

RECORD

Cased _____ in., _____ ft.

Sand _____

Gas _____

Oil _____

Total Depth _____

PRODUCTION

1st 24 hrs. Nat. _____

1st 24 hrs. after shot _____

Gas _____ Cu. Ft.

Dry Hole _____

Abandoned _____

Date

APR 11 1928

192_____

S. J. LEWIS

Scout

Map No. KANSAS Sec. 14 Twp. 32 R. 2E

Well No. 9 Gassaway

Stanton & Co Company

Contractor

SECTION PLAT

_____ Ft. from N. Line

270 Ft. from S. Line

1050 Ft. from E. Line

_____ Ft. from W. Line

COMPLETED

Location _____

Rig up _____

Drilling and Remarks:

718-1605

711 1633

20/1613-27

150886 24 hrs

swatted

RECORD

Cased _____ in., _____ ft.

Sand _____

Gas _____

Oil _____

Total Depth _____

PRODUCTION

1st 24 hrs. Nat. _____

1st 24 hrs. after shot _____

Gas _____ Cu. Ft.

Dry Hole _____

Abandoned _____

Date

MAY 16 1928

192

S. J. LEWIS

Scout

Map No. 1 Sec. 14 Twp. 32 R. 2 EWell No. 9- Wasson
Amerada + Sunray Company

Contractor

O. W. D. D.
FIRST REPORTS

SECTION PLAT

Ft. from N. Line

270 Ft. from S. Line1050 Ft. from E. Line

Ft. from W. Line

O.W.D.D.

Do not have record
of old well

Location

Rig up

Drilling and Remarks:

OTN 1633

RECORD

Cased.....in.,ft.

Sand.....

Gas.....

Oil.....

Total Depth.....

PRODUCTION

1st 24 hrs. Nat.....

1st 24 hrs. after shot.....

Gas.....Cu. Ft.

Dry Hole.....

Abandoned.....

CORRECTION

Co Name from
Wasson to Amerada
Sunray oil

Date

6-26-35

192

ORVAL MANNSCHRECK

Scout

KANSAS

Map No. 1 Sec. 14 Twp. 32 R. 2EWell No. 9-GrasswayAmerada-Sunray Company

Contractor

COMPLETED

SECTION PLAT

	0		

Ft. from N. Line

270 Ft. from S. Line1050 Ft. from E. Line

Ft. from W. Line

Location

Rig up

Drilling and Remarks:

flow
5820 bbls

RECORD

Cased in. 2820 ft.Sand Simpson

Gas

Oil

Total Depth 2886

PRODUCTION

1st 24 hrs. Nat.

1st 24 hrs. after shot

Gas Cu. Ft.

Dry Hole

Abandoned

Date

8-14-35 192

ORVAL MANNSCHRECK

Scout