


Summer  
32 R. 2E

Map No. 14 Sec. 14 Twp. 32 R. 2E

Well No. 14- Passoway Farm  
Ameraka - Aubrey Company

NORTH

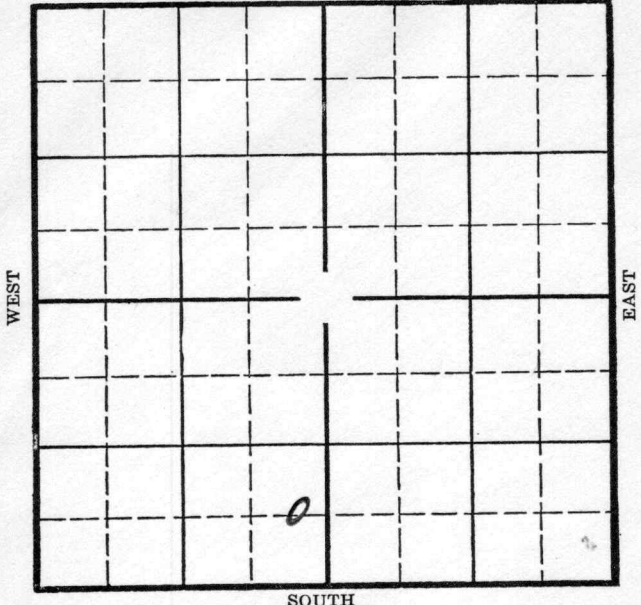

Location \_\_\_\_\_  
Drilling Remarks \_\_\_\_\_

Rig Up \_\_\_\_\_  
Drilling Remarks \_\_\_\_\_

\_\_\_\_\_  
 \_\_\_\_\_  
RECORD

PRODUCTION

Cased \_\_\_\_\_ in. \_\_\_\_\_ ft.  
 Sand \_\_\_\_\_  
 Gas \_\_\_\_\_  
 Oil \_\_\_\_\_  
 Total Depth \_\_\_\_\_

1st 24 hrs. Nat. \_\_\_\_\_  
 1st 24 hrs. after shot \_\_\_\_\_  
 Gas \_\_\_\_\_ cu. ft. \_\_\_\_\_  
 Dry Hole \_\_\_\_\_  
 Abandoned \_\_\_\_\_

*Summer*

Map No.            Sec. 14 Twp. 32 R. 2E

Well No. 14 - Gyssoy Farm             
Amerasia - Summer Company           


**KANSAS**

\_\_\_\_\_ Ft. from N. Line

661 Ft. from S. Line

200 Ft. from E. Line

\_\_\_\_\_ Ft. from W. Line

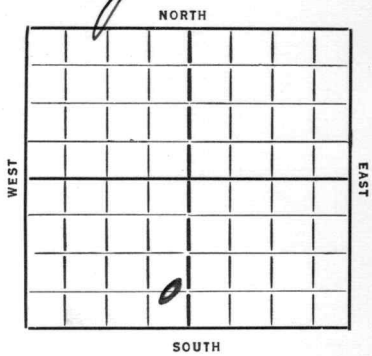

**REPORT**

~~1935~~  
 9/20 *Cellar*  
 10/3 *15" 266*  
 10/10 *shy 1755*  
 10/30 *shl. 2800*  
*TD 2889*  
*27,706 Bbls.*

**COMPLETED**



