


Map No. _____ Sec. 14 Twp. 3E R. 2E
 Well No. 1A - Bassway Farm _____
Wasson et al. Company _____
AMERADA NORTH SUNRAY

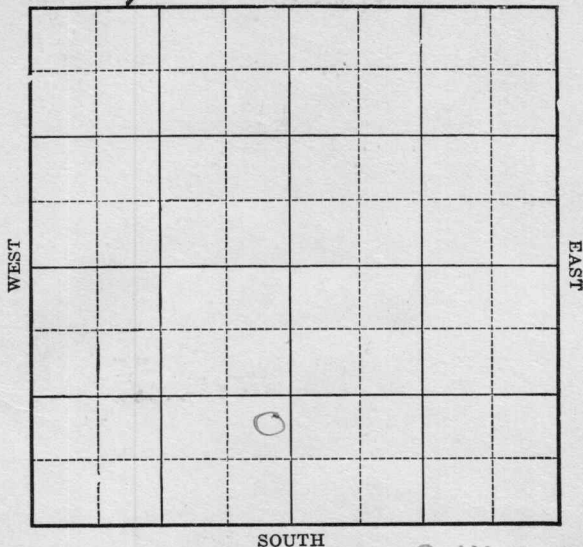

O. W. D. D

Location _____

Drilling Remarks _____

Rig Up _____

Drilling Remarks _____

RECORD

Cased _____ in. _____ ft.

Sand _____

Gas _____

Oil _____

Total Depth _____

PRODUCTION

1st 24 hrs. Nat. _____

1st 24 hrs. after shot _____

Gas _____ cu. ft.

Dry Hole _____

Abandoned _____

Map No. Kansas Sec. 14 Twp. 32 R. 2EWell No. 1-H-Gassoway FarmGassoway et al CompanyAMERADAT SUNRAY NORTH

Ft. from N. Line

1140

Ft. from S. Line

1150

Ft. from E. Line

220

Ft. from W. Line

WEST

EAST

SOUTH

1927Swine to #1

Date

REPORT

O. W. D. D

11/16Pond11/22Spud11/29Drilg 78512/7" 134012/14" 1990-top sand 1950-12/21Top sand 1950 - T.D. 2071-shot 180 qts. 1969-2071-1658 bbls 10 hrs- bridged-12/28T.S. 1950 T.D. 2071180/1969-2071flowed & swabbed2245 bbls 24 hrs1935

O. W. D. D

8/14Rgn Rotary8/22leg 10"8/29leg 23309/6" 27059/14T Dolomite 2801T.D. 2837flow 1638 bbls in 1 hr38 Grad.(OVER) (2)

9/25 Dolomite 2801
77 2837
37, 466 Bbls.

COMPLETED


Map No. KANSAS Sec. 14 Twp. 22 R. 2E

Well No. 1-A. Gassaway

Gasson & Co. Company

Contractor

SECTION PLAT

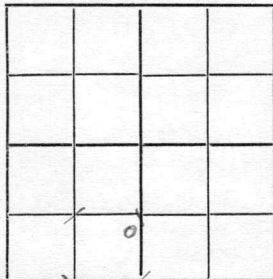

----- Ft. from N. Line

1150 Ft. from S. Line

220 Ft. from E. Line

----- Ft. from W. Line

FIRST REPORTS

Location -----

Rig up -----

Drilling and Remarks:

Pond
Twin to No 1

RECORD

Cased ----- in., ----- ft.

Sand -----

Gas -----

Oil -----

Total Depth -----

PRODUCTION

1st 24 hrs. Nat. -----

1st 24 hrs. after shot -----

Gas ----- Cu. Ft.

Dry Hole -----

Abandoned -----

Date

NOV 16 1927

192

S. J. LEWIS

Scout


Map No. KANSAS Sec. 14 Twp. 32 R. 2E

Well No. 1-A Gassoway

Hasson & Co Company

Contractor

SECTION PLAT

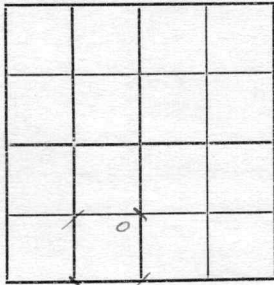

_____ Ft. from N. Line

1150 Ft. from S. Line

220 Ft. from E. Line

_____ Ft. from W. Line

COMPLETED

Location _____

Rig up _____

Drilling and Remarks:

Dec. 1950

TD 2071

180/1969-2071

Flowed & swabbed

2245886-24142

RECORD

Cased _____ in., _____ ft.

Sand _____

Gas _____

Oil _____

Total Depth _____

PRODUCTION

1st 24 hrs. Nat. _____

1st 24 hrs. after shot _____

Gas _____ Cu. Ft.

Dry Hole _____

Abandoned _____

Date

DEC 28 1927

S. J. LEWIS

Scout

Map No. 1 Sec. 14 Twp. 32 R. 2E

Well No. 1A - Cassoway

Amherada - Dunray Company

Contractor

FIRST REPORT

SECTION PLAT

Ft. from N. Line

1140 Ft. from S. Line

220 Ft. from E. Line

Ft. from W. Line

OWP N

Location

Rig up

Drilling and Remarks:

OTd 2071

Rign
Rotary

RECORD

Cased in, ft.

Sand

Gas CORRECTION

Oil to name of feet

Total Depth measurements

PRODUCTION

1st 24 hrs. Nat.

1st 24 hrs. after shot

Gas Cu. Ft.

Dry Hole

Abandoned

Date

8-14-35

192

ORVAL MANN SCHRECK

Scout

Map No. 1 Sec. 14 Twp. 37 R. 2EWell No. 1A-BassowayAmeraka Sunray Company

Contractor

COMPLETED

SECTION PLAT

Ft. from N. Line

1140 Ft. from S. Line220 Ft. from E. Line

Ft. from W. Line

Location

Rig up

Drilling and Remarks:

RECORD

Cased in ft.

Sand Colomite 2801

Gas

Oil

Total Depth 2837

PRODUCTION

1st 24 hrs. Nat.

1st 24 hrs. after shot

Gas Cu. Ft.

Dry Hole

Abandoned

Date

9-25-35 192

Scout

ORVAL MANNSCHRECK