


Section 14 Township 32 Range 2E

Well No. #2 Lerke

Company Lerke & Whortaon et al

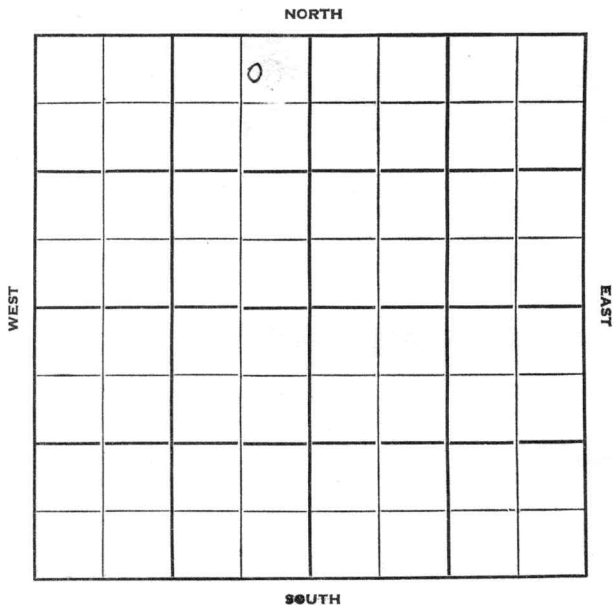

Sec. 14 Twp. 32 R. 2E

Well No. #2 Lerke Farm

Lerke & Whorton et al Company

Contractor

Oxford Pool


425' Ft. from N. Line

\_\_\_\_\_ Ft. from S. Line

500' Ft. from E. Line

\_\_\_\_\_ Ft. from W. Line

NE NE NW

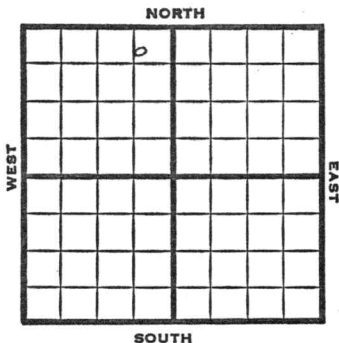

1951

Elev. 1171' REPORT

6/6  
6/15

Location  
 Spud 6-15-51  
 SWD well TD 3555  
 10" @ 150  
 Stal 2163  
 KC 2591  
 Miss 3142  
 Simp. 3484  
 DST 3484-97 Rec. mud  
 Arb. 3519  
 DST 3519-55 opn 1/2 hr  
 Rec. 330' mud 660' sw  
 5" @ 2400 183/2168-2338  
 Comp. for SWD well

**ABANDONED**

County Sumner State Kansas

Sec. 14 (Blk. 32) (Sur. Rge.) 2E Map No.

Operator Lerke & Whorton etal.

Well No. 2 Farm Lerke

Elev. Location NE NE NW

		0			

425 Ft. From N Line NW

500 Ft. From E Line Quarter

lst. Report JUN 6 1951

Completion \_\_\_\_\_

Remarks \_\_\_\_\_

Spudding Date \_\_\_\_\_

Drlg. Data Oxford Pool

**Location**

J. E. TYRA

County Sumner State Kansas

Sec. 14 (Blk. 32 (Sur. Rge.) 2E) Map No.

Operator Lerke & Whorton etal.

Well No. 2 Farm Lerke

Elev. 1171 Location NE NE NW

		0			
<b>COMPLETE</b>					
<b>ABANDONED</b>					

425 Ft. From N Line NW

500 Ft. From E Line Quarter

1st. Report

Completion AUG 15 1951

Remarks Oxford Pool

Spudding Date 6-15-51

Drlg. Data SWD well TD 3555

10" @ 150 Stal. 2163 KC 2591

Miss. 3142 Simp. 3484 DST 3484-97

Rec. mud Arb. 3519 DST 3519-55

open  $\frac{1}{2}$  hr. Rec. 330' mud 660' sw

5" @ 2400 183/ 2168-2338

Comp. for SWD well

J. E. TYRA