

Map No. _____ Sec. 14 Twp. 32 R. 2E


Well No. 3 - Rothwell Farm
Rokana Pet Company

1010 Ft. from N. Line

_____ Ft. from S. Line

1132 Ft. from E. Line

_____ Ft. from W. Line

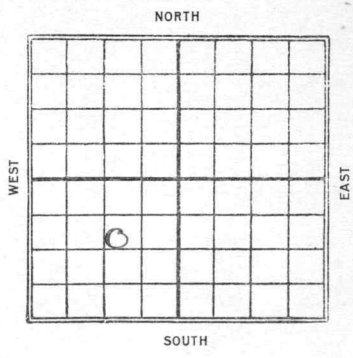

1928

Date	REPORT
<u>2/1</u>	<u>Rig</u>
<u>2/15</u>	<u>T.D. 690 - fishing tools -</u>
<u>2/22</u>	<u>T.D. 690 - straight-running</u>
<u>2/29</u>	<u>skid rig - T.D. 690 -</u>
<u>3/7</u>	<u>Drly 495</u>
<u>3/14</u>	<u>" 730</u>
<u>3/21</u>	<u>" 1485</u>
<u>3/28</u>	<u>Top sand 1620 - 50 base</u>
	<u>filled up 1300' oil - drly 1810.</u>
<u>4/4</u>	<u>T.S. 1983 T.D. 2101</u>
	<u>180/2007-2101</u>
	<u>swabbed 742. bbls</u>
	<u>24 hrs</u>

Map No. **KANSAS** Sec. 14 Twp. 32 R. 25

Well No. 3 Rothwell

Roxana Pet. Corp. Company

Contractor

SECTION PLAT

1010 Ft. from N. Line

----- Ft. from S. Line

1132 Ft. from E. Line

----- Ft. from W. Line

FIRST REPORTS

Location -----

Rig up -----

Drilling and Remarks:

Rig

RECORD

Cased ----- in., ----- ft.

Sand -----

Gas -----

Oil -----

Total Depth -----

PRODUCTION

1st 24 hrs. Nat. -----

1st 24 hrs. after shot -----

Gas ----- Cu. Ft.

Dry Hole -----

Abandoned -----

Date

FEB 1 - 1929

S. J. LEWIS Scout

Map No. **KANSAS** Sec. *14* Twp. *32* R. *2E*

Well No. *3 Rothwell*

Roxana P. & C. Corp. Company

Contractor


SECTION PLAT

1010 Ft. from N. Line

----- Ft. from S. Line

1132 Ft. from E. Line

----- Ft. from W. Line

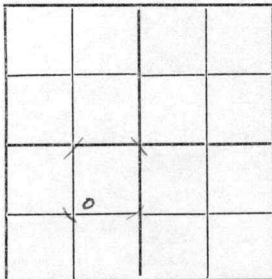

COMPLETED

Location -----

Rig up -----

Drilling and Remarks:

Th. 1983

TII 2101

180/2007-2101

swatted 742886

24 hrs.

RECORD

Cased ----- in., ----- ft.

Sand -----

Gas -----

Oil -----

Total Depth -----

PRODUCTION

1st 24 hrs. Nat. -----

1st 24 hrs. after shot -----

Gas ----- Cu. Ft.

Dry Hole -----

Abandoned -----

Date

APR 4 - 1928

S. J. LEWIS

Scout