


Summer
32 *2E*

Map No. **KANSAS** Sec. *14* Twp. *32* R. *2E*

Well No. *4-A Scroggins* Farm
Shell Pit Company

NORTH

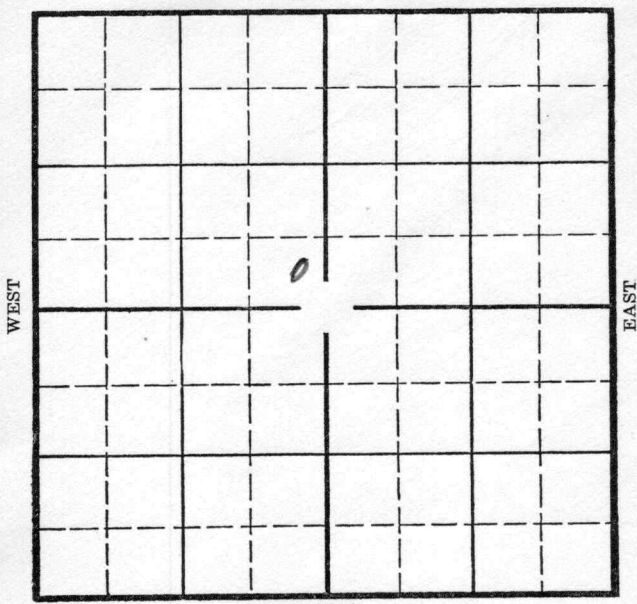

SOUTH

Location _____
Drilling Remarks _____

Rig Up _____
Drilling Remarks _____

RECORD

PRODUCTION

Cased _____ in. _____ ft.
 Sand _____
 Gas _____
 Oil _____
 Total Depth _____

1st 24 hrs. Nat. _____
 1st 24 hrs. after shot _____
 Gas _____ cu. ft. _____
 Dry Hole _____
 Abandoned _____

Summer

Map No. KANSAS Sec. 14 Twp. 32 R. 2E

Well No. 4-A Scroggins Farm
Shell Pit Company


_____ Ft. from N. Line

220 Ft. from S. Line

220 Ft. from E. Line

_____ Ft. from W. Line

Elev. 1173

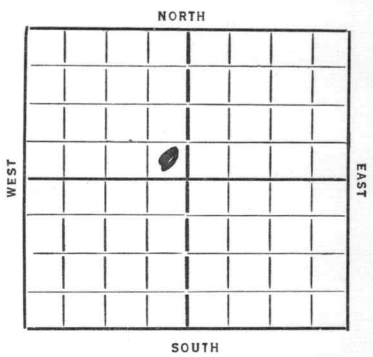

REPORT

1935
12/4 15 1/2 248 WOC
12/12 Dlg 1164
12/19 " 2360
12/26 " 2800
12/36 TD 2980 8" 2816
1/10 TD 2897 flowed 230 oil
 pu hr ring tuby
1/15 Dlg 2816
 TD 2894
 3000 acid
 8000 "
 11,042 bbls

COMPLETED

Map No. 1 Sec. 14 Twp. 32 R. 2E

Well No. 4A-Scroggins

Shell pet Company

Contractor

FIRST REPORTS

SECTION PLAT

Ft. from N. Line

220 Ft. from S. Line

220 Ft. from E. Line

Ft. from W. Line

	6		

Location

Rig up

Drilling and Remarks:

15 1/2 248 WOC

RECORD

Cased in., ft.

Sand

Gas

Oil

Total Depth

PRODUCTION

1st 24 hrs. Nat.

1st 24 hrs. after shot

Gas Cu. Ft.

Dry Hole

Abandoned

Date

12-4-35

192

ORVAL MANNSCHEIDT

Scout

Map No. 1 Sec. 14 Twp. 32 R. 2E

Well No. 47-Scroggins

shell pit

Company

Contractor

COMPLETE

SECTION PLAT

Ft. from N. Line

220 Ft. from S. Line

220 Ft. from E. Line

Ft. from W. Line

	0		

RECORD

Location

Cased in, ft.

Rig up

Sand 1102 2816

Drilling and Remarks:

Gas

Oil

Total Depth 2894

3000 acid
8000 acid

PRODUCTION

1st 24 hrs. Nat.

1st 24 hrs. after shot

Gas Cu. Ft.

Dry Hole

Abandoned

11,042
bbls

Date

1-15-36 192 Scout

ORVAL MANN SCHRECK