


Sumner

Form 51-5M-4-27-27423

Map No. KANSAS Sec. 14 Twp. 32 R. 2 E
Well No. 3-A Scroggins Farm
Rotana Oil Co. Company
NORTH Shell Pit

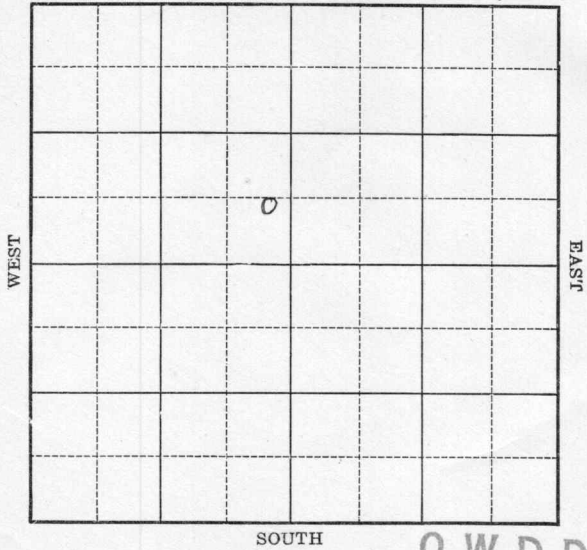

O. W. D. D

Location _____
Drilling Remarks _____

Rig Up _____
Drilling Remarks _____

RECORD


Cased _____ in. _____ ft.
Sand _____
Gas _____
Oil _____
Total Depth _____

PRODUCTION

1st 24 hrs. Nat. _____
1st 24 hrs. after shot _____
Gas _____ cu. ft.
Dry Hole _____
Abandoned 42

Map No. KANSAS Sec. 14 Twp. 32 R. 2 E
Well No. 3-A-Scripps Farm
Roxana Oil Co. Company
Shell Pit

.....Ft. from N. Line
640 Ft. from S. Line
220 Ft. from E. Line
.....Ft. from W. Line

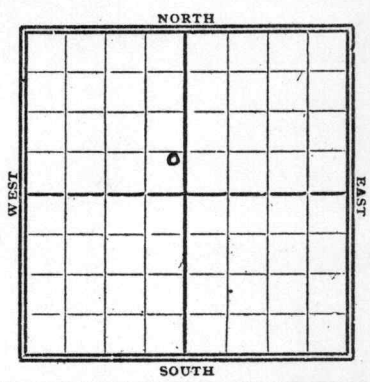

1928

Date	REPORT	O. W. D. D
8/15	Rigging up	
8/22	Spud 235'	
9/15	Drilg 1396	
9/12	" 1760	
9/19	sand 2040-76	
	shot 70 gts	
	147 bbls oil	} 18 hrs.
	10 bbls. wh	
	Camp	

1936	O. W. D. D
3/18	Rgn to deeper
3/20	--
3/27	Drilg. 2400'
4/2	T. Dolo. 2835' - 7" - 2836' RUST.
4/10	T.D. 2873' Swabb 265 oil.
4/15	Top line 2836
	TD 2884
	2000 & 5000 acid
	740 Bbls.

COMPLETED

MAP No. KANSAS SEC. 14 TWP. 32 R. 2E

WELL No. 3-7 Scroggins

Roxana Ref. Corp. COMPANY

CONTRACTOR

SECTION PLAT

	0		

Ft. FROM N. LINE

640 Ft. FROM S. LINE

220 Ft. FROM E. LINE

Ft. FROM W. LINE

FIRST REPORTS

LOCATION _____

RIG UP _____

DRILLING AND REMARKS:

Rigging up

RECORD

CASED _____ IN., _____ FT.

SAND _____

GAS _____

OIL _____

TOTAL DEPTH _____

PRODUCTION

1ST 24 HRS. NAT. _____

1ST 24 HRS. AFTER SHOT _____

GAS _____ CU. FT.

DRY HOLE _____

ABANDONED _____

DATE

AUG 15 1928

192

S. J. LEWIS

SCOUT

Summer
K1 KANSAS
 MAP NO. _____ SEC. 14 TWP. 32 R. 2E

WELL NO. 37 Scroggins

Roxana Oil Corp. COMPANY

 CONTRACTOR

SECTION PLAT

 FT. FROM N. LINE

640
 FT. FROM S. LINE

220
 FT. FROM E. LINE

 FT. FROM W. LINE

COMPLETED

LOCATION _____

RIG UP _____

DRILLING AND REMARKS:

Sand 2040-2076
Slut 709 to
14 7/8" oil
10 7/8" water
18 hrs.

RECORD

CASED _____ IN. _____ FT.

SAND _____

GAS _____

OIL _____

TOTAL DEPTH _____

PRODUCTION

1ST 24 HRS. NAT. _____

1ST 24 HRS. AFTER SHOT _____

GAS _____ CU. FT.

DRY HOLE _____

ABANDONED _____

DATE

SEP 19 1928

192

S. J. LEWIS

SCOUT

Map No. 1 Sec. 14 Twp. 32 R 2EWell No. 3A-L. B. ScrogginsShell Petroleum Company

Contractor


FIRST REPORT

SECTION PLAT

Ft. from N. Line

640 Ft. from S. Line220 Ft. from E. Line

Ft. from W. Line

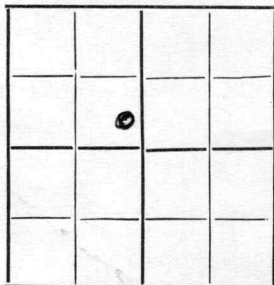

Location

Rig up

Drilling and Remarks:

OTD 2076
Rgn

RECORD

Cased _____ in., _____ ft.

Sand _____

Gas _____

Oil _____

Total Depth _____

PRODUCTION

1st 24 hrs. Nat. _____

1st 24 hrs. after shot _____

Gas _____ Cu. Ft.

Dry Hole _____

Abandoned _____

Date

ORVAL MANNSCHRECK


3-18-36 192 _____ Scout

KANSA

Map No. 1 Sec. 14 Twp. 32 R. 2EWell No. 3-"a" ScrogginsShell P&S Company

Contractor

SECTION PLAT

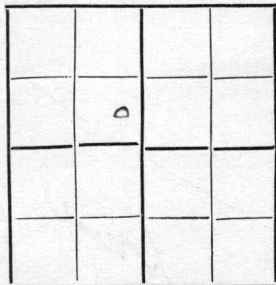

Ft. from N. Line

640 Ft. from S. Line220 Ft. from E. Line

Ft. from W. Line

COMPLETED

Location

Rig up

Drilling and Remarks:

Top line 25362000 acid
5000 "740 gph.

RECORD

Cased in., ft.Sand Gas Oil Total Depth 2884

PRODUCTION

1st 24 hrs. Nat. 1st 24 hrs. after shot Gas Cu. Ft.Dry Hole Abandoned

Date

APR 15 1936

S. J. LEWIS

192

Scout