

# KANSAS

See

Twp

R...

2 E

Map No

Well No.

*Ed Farm*

Company

NORTH

WEST

EAST

SOUTH

O. W. D. D.

Location .....

### Drilling Remarks

Rig Up\_\_\_\_\_

### Drilling Remarks

RECORD

Cased.....in. ....ft.

Sand .....

Gas .....

Oil \_\_\_\_\_

Total Depth.....

## PRODUCTION

1st 24 hrs. Nat. ....

1st 24 hrs. after shot.....

Gas..... cu. ft.

Dry Hole .....

Abandoned .....

Map No. KANSAS Sec. 14 Twp. 32 R. 2 E  
 #1-B SCROGGINS  
 Well No. Red Barnes Farm  
Acana Pet Company  
Shell Pet

Ft. from N. Line

1103

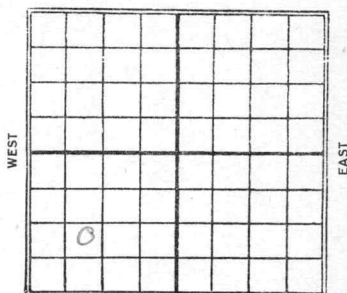
Ft. from S. Line

1100

Ft. from E. Line

1087

Ft. from W. Line

1100

SOUTH

1928

Date

REPORT

O. W. D. D.

2/15 Rigging up  
 2/22 Spud 195  
 2/29 Drlg 530  
 3/7 " 815  
 3/14 " 1395  
 3/21 " 1810  
 3/28 Top Sand 2010 - 2104 - T.D.  
 Shot 170 qts 2032 - 2102  
 fishing pipe -  
 4/4 underream 6" to reset.  
 4/11 Shot 150 qts 2025 - 2102 - C.O.  
 4/18 T.S. 2010 T.D. 2104  
 170/2032 - 2102  
 150/2025 - 2102  
 swabbed 391 bbls  
 24 hrs  
 1935  
 9/20 Dly 2203  
 10/3 7" 2875 to 2915-17  
 1000' 5 hrs air size  
 (OVER)

10/10 4000 acid  
322 Bbls 17 hrs.  
10,000 acid No Inc  
To deeper

11/1 T D 2967  
Swabbed 192 Oil & 137 wto  
19 hrs S.D.

11/7 T D 2988  
Swabbed 200 Oil & 57 wto 4 hrs.

11/14 —

11/20 T D 2988  
10,000 acid  
662 Bbls.

COMPLETED

Map No. **KANSAS** Sec. 14 Twp. 32 R. 2E

Well No. 1 Fred Barnes

Roxana Pet. Corp. Company

Contractor

SECTION PLAT

|   |  |  |  |
|---|--|--|--|
|   |  |  |  |
|   |  |  |  |
|   |  |  |  |
| 0 |  |  |  |

-----Ft. from N. Line

1100 Ft. from S. Line

-----Ft. from E. Line

1100 Ft. from W. Line

FIRST REPORTS

Location -----

Rig up -----

Drilling and Remarks:

*Rigging up*

RECORD

Cased ----- in., ----- ft.

Sand -----

Gas -----

Oil -----

Total Depth -----

PRODUCTION

1st 24 hrs. Nat. -----

1st 24 hrs. after shot -----

Gas ----- Cu. Ft.

Dry Hole -----

Abandoned -----

Date

**FEB 15 1928**  
-----192-----

**S. J. LEWIS**  
-----Scout

Map No. **KANSAS** Sec. 14 Twp. 32 R. 2E

Well No. 1 Fred Barnes

Roxana Pet. Corp. Company

Contractor

### SECTION PLAT

|   |  |  |  |
|---|--|--|--|
|   |  |  |  |
|   |  |  |  |
|   |  |  |  |
| 0 |  |  |  |

\_\_\_\_\_ Ft. from N. Line

400 Ft. from S. Line

\_\_\_\_\_ Ft. from E. Line

1100 Ft. from W. Line

## COMPLETED

Location \_\_\_\_\_

Rig up \_\_\_\_\_

Drilling and Remarks:

TD 2010

TD 2104

170/2032-2102

155/2025-2102

Swatted 3918 ft

24 hrs.

### RECORD

Cased \_\_\_\_\_ in., \_\_\_\_\_ ft.

Sand \_\_\_\_\_

Gas \_\_\_\_\_

Oil \_\_\_\_\_

Total Depth \_\_\_\_\_

### PRODUCTION

1st 24 hrs. Nat. \_\_\_\_\_

1st 24 hrs. after shot \_\_\_\_\_

Gas \_\_\_\_\_ Cu. Ft.

Dry Hole \_\_\_\_\_

Abandoned \_\_\_\_\_

Date

APR 18 1928 192

S. J. LEWIS

Scout

KANSAS

Map No. 1 Sec. 14 Twp. 32 R. 2 EWell No. 1B- ScrogginsShell pet Company

Contractor

FIRST REPORTS

## SECTION PLAT

|   |  |  |  |
|---|--|--|--|
|   |  |  |  |
|   |  |  |  |
|   |  |  |  |
|   |  |  |  |
| 0 |  |  |  |

Ft. from N. Line

1103 Ft. from S. Line

Ft. from E. Line

1087 Ft. from W. Line

Location

Rig up

Drilling and Remarks:

OT& 2104229 2203

CORRECTION

CHANGE WELL #

" FARM NAME

" FEET MEASUREMENTS

## RECORD

Cased.....in., .....ft.

Sand.....

Gas.....

Oil.....

Total Depth.....

## PRODUCTION

1st 24 hrs. Nat.....

1st 24 hrs. after shot.....

Gas.....Cu. Ft.

Dry Hole.....

Abandoned.....

Date

9-20-35

192

ORVAL MANNSCHRECK

Scout

KANSAS

Map No. 1 Sec. 14 Twp. 32 R. 2 EWell No. 1B- ScrogginsShell pit Company

Contractor

COMPLETE

SECTION PLAT

|   |  |  |  |
|---|--|--|--|
|   |  |  |  |
|   |  |  |  |
|   |  |  |  |
|   |  |  |  |
| 0 |  |  |  |

Ft. from N. Line

1103 Ft. from S. Line

Ft. from E. Line

1087 Ft. from W. LineSwdd

Location

Rig up

Drilling and Remarks:

10,000 and662 bbls

## RECORD

Cased in., ft.

Sand

Gas

Oil

Total Depth 2988

## PRODUCTION

1st 24 hrs. Nat.

1st 24 hrs. after shot

Gas Cu. Ft.

Dry Hole

Abandoned

Date

11-20-35 192

ORVAL MANNSCHRECK

Scout