


Map No. KANSAS Sec. 14 Twp. 32 R. 2 E
Well No. #3-B SCROGGINS Farm
Rocana Petroleum SHELL Company

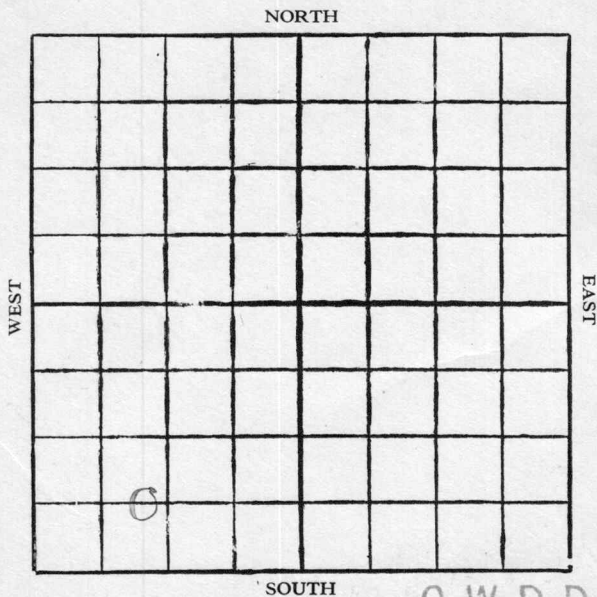

Location

Drilling Remarks

Rig Up.....

Drilling Remarks

RECORD

Cased in. ft.

Sand

Gas

Oil

Total Depth

PRODUCTION

1st 24 hrs. Nat.

1st 24 hrs. after shot


Gas cu. ft.

Dry Hole

Abandoned

KANSAS
 Map No. _____ Sec. 14 Twp. 32 R. 2E
 Well No. #3-B SCROGGINS Farm
Rocana Pet SHELL Company

NORTH

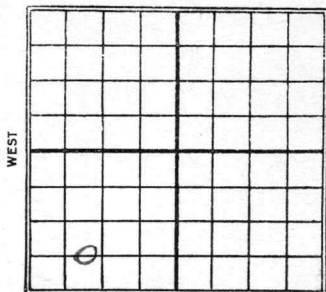

SOUTH

Ft. from N. Line

Ft. from S. Line

Ft. from E. Line

Ft. from W. Line

1928

Date

REPORT

O. W. D. D

2/29 Location

3/7 Spud

3/14 Drilg 875

3/21 " 1710

3/28 T.S. 1995 T.D. 2106

170/2010-2106

flowed 1762. bbls

23 hrs

1935 O. W. D. D

7/7 Rigw

7/11 B C 2433 Drilg 2452

7/18 B C 2474 Rimp Shale 2870

Rimp dol 2871 2874 T.D.

8/8 2900 T7 flow 450 8 hrs.

8/14 Simpson 2871

T7 2517 2900

2517 bbls flow.

COMPLETED

1935 O. W. D. D

10/24 TD 2906 172' Water

PB 2902.

(OVER)

11/1 AB 2902

11/13 TD 2906

AB 2902

2517 Bbls

COMPLETED

Map No. **KANSAS** Sec. 14 Twp. 22 R. 25Well No. 3 BarnesRoxana P. & Co. Company

Contractor

SECTION PLAT

Ft. from N. Line

660 Ft. from S. Line

Ft. from E. Line

1100 Ft. from W. Line

FIRST REPORTS

Location ✓

Rig up

Drilling and Remarks:

RECORD

Cased _____ in., _____ ft.

Sand _____

Gas _____

Oil _____

Total Depth _____

PRODUCTION

1st 24 hrs. Nat. _____

1st 24 hrs. after shot _____

Gas _____ Cu. Ft.

Dry Hole _____

Abandoned _____

Date

FEB 29 1929

192

S. J. LEWIS

Scout

Map No. **KANSAS** Sec. 14 Twp. 32 R. 25

Well No. S. F. Barnes

Roxana P. & Co. Inc. Company

Contractor

SECTION PLAT

_____ Ft. from N. Line

660 Ft. from S. Line

_____ Ft. from E. Line

1100 Ft. from W. Line

0			

COMPLETED

Location _____

Rig up _____

Drilling and Remarks:

Feb. 1995

TD 2106

170/2010-2106

Flowed 1762 & 4

23 hrs.

RECORD

Cased _____ in., _____ ft.

Sand _____

Gas _____

Oil _____

Total Depth _____

PRODUCTION

1st 24 hrs. Nat. _____

1st 24 hrs. after shot _____

Gas _____ Cu. Ft.

Dry Hole _____

Abandoned _____

Date

MAR 28 1928

S. J. LEWIS

Scout

Map No. 1 Sec. 14 Twp. 32 R. 2 EWell No. 313-ScrogginShell putCORRECTION
Correct measurements
Well & Form

FIRST REPORTS SECTION PLAT

Ft. from N. Line

638 Ft. from S. Line

Ft. from E. Line

1076 Ft. from W. Line

Location.....

Rig up.....

Drilling and Remarks:

Rig in
Do not have
record of old
well

RECORD

Cased.....in.,ft.

Sand.....

Gas.....

Oil.....

Total Depth.....

PRODUCTION

1st 24 hrs. Nat.....

1st 24 hrs. after shot.....

Gas.....Cu. Ft.

Dry Hole.....

Abandoned.....

Date

7-2-35 192.....

ORVAL MANNSCHRECK

Scout

Orval:

Check your records we show no number three well located at the feet measurements you give on this ticket. We show two wells completed in NE SW SW but the well number and feet measurements do not agree with this ticket.

Sam

Sam:
Location now correct as furnished by Shell office. I did not have record of old 3 well and just reported it as it was given out at check meeting.

~~o.m. Team~~
~~pool. Com. Team~~
~~pool. sued my~~

Returned	ROS
Cards	
Tracing	JIP
France Map	JIP
Scarborough Map	JIP
Moody Map	X
Scarborough Plat Book	
Moody Plat Book	

Wall used

Map No. 1 Sec. 14 Twp. 32 R. 2 EWell No. 3B-ScrogginsShell pit. Company

Contractor

COMPLETED

SECTION PLAT

Ft. from N. Line

638 Ft. from S. Line

Ft. from E. Line

1076 Ft. from W. Line

Location

Rig up

Drilling and Remarks:

RECORD

Cased in. 2871 ft.Sand 2871

Gas

Oil

Total Depth 2517

PRODUCTION

1st 24 hrs. Nat.

1st 24 hrs. after shot

Gas Cu. Ft.

Dry Hole

Abandoned

Date

8-14-35 192

ORVAL MANNSCHRECK

Scout

Map No. 1 Sec. 14 Twp. 32 R. 23Well No. 3B- CrogginsShell pit CompanyCorrect Feet Contractor

SECTION PLAT

Ft. from N. Line

660 Ft. from S. Line

Ft. from E. Line

990 Ft. from W. LineCwd

Location

Rig up

Drilling and Remarks:

OTD 2900Td 2906172' WaterP.B. 2902

RECORD

Cased.....in.,ft.

Sand.....

Gas.....

Oil.....

Total Depth.....

PRODUCTION

1st 24 hrs. Nat.....

1st 24 hrs. after shot.....

Gas.....Cu. Ft.

Dry Hole.....

Abandoned.....

Date

ORVAL MANNSCHRECK

10-24-35 192

Scout

Map No. 1 Sec. 14 Twp. 32 R. 2 EWell No. 3B-ScrogginsShell pit Company

Contractor

COMPLETED

SECTION PLAT

Ft. from N. Line

660 Ft. from S. Line

Ft. from E. Line

990 Ft. from W. Line

0	.		

owdd

Location.....

Rig up.....

Drilling and Remarks:

P.B. 29022517 bbls

RECORD

Cased.....in.,ft.

Sand.....

Gas.....

Oil.....

Total Depth 2906

PRODUCTION

1st 24 hrs. Nat.....

1st 24 hrs. after shot.....

Gas.....Cu. Ft.

Dry Hole.....

Abandoned.....

Date

11-13-32 192..... Scout

ORVAL MANN SCHRECK