

Sumner

KANSAS

DX 78-1

Section 17 Township 32 Range 2E


Well No. 1 Dora Barnes

Company Russell Cobb

NORTH

WEST

EAST

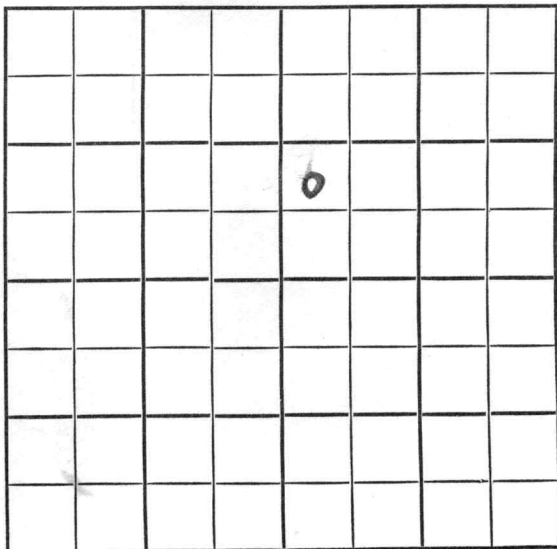

SOUTH

Sumner

KANSAS

SEC.	TWP.	R.
17	32	2E

WELL NO.

1 Dora Barnes

FARM

COMPANY

Russell Cobb

CONTRACTOR

Martin

W. Oxford

Ft. from N. Line


890

Ft. from S. Line

Ft. from E. Line

Ft. from W. Line

nW SW NE

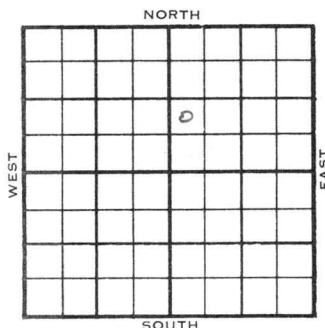

1955

ELEVATION

1261

REPORT

6/29

Comm 6-27-55

8" @ 100/95

WOC

7/27

Comm 6-27-55

Tp Lay 2390, L 2794, M Li 3355,

S 3655, A 3705,

TD 3709

8" @ 100/95 DST 3652-76 open 1 hr

Rec 5' mud 35/30" 5 1/2" @ 3705

CO to 3699 20/3692-96 B/25 go 1 hr

frac Comp 40 bopd 40 bw

COMPLETED

County Sumner Elev. _____
Sec. 17 Twp. 32 Rge. 2E
Company Russell Cobb
Farm Name Dora Barnes No. 1

TOPS	DEPTH	LOG	DATUM
Anh.			
T.P.			
H.			
Tr.			
Dg.			
BL.			
L.			
K.C.			
B.K.C.			
Ce.			
C.			
M.			
M.			
K.			
Mz.			
Mq.			
V.			
S.			
S.			
A.			
R.			
Pe.			
G.			
T.D.			

Loc. in Sec. _____
NW SW NE
890' SL
Geol. _____
Contr. Martin
Pool _____
W. Oxford

JUN 29 '55
FIRST REPORT

Date Comm. 6-27-55
8" @ 100/95 WOC

County Sumner Elev. 1261Sec. 17 Twp. 32 Rge. 2ECompany Russell CobbFarm Name Dora BarnesNo. 1

TOPS	DEPTH	LOG	DATUM	Loc. in Sec.
Anh.				
Tp. <u>Lay</u>	<u>2390</u>		<u>1129</u>	<u>NW SW NE</u>
H.				<u>890' SL</u>
Tr.				
Dg.				
BL.				
L.	<u>2794</u>		<u>1533</u>	Geol.
K.C.				Contr.
B.K.C.				<u>Martin</u>
Ce.				Pool
C.				<u>W. Oxford</u>
M. <u>Li</u>	<u>3355</u>		<u>2094</u>	
M.				
K.				
Mz.				
Mq.				
V.				
S.	<u>3655</u>		<u>2394</u>	
S.				
A.	<u>3705</u>		<u>2444</u>	
R.				
Pe.				
G.				
T.D.	<u>3709</u>			

COMPLETE

Date Comm. 6-27-55 JUL 27 1955

8" @ 100/95 DST 3652-76 open 1 hr.

Rec. 5' mud 35/30" 5 1/2" @ 3705

CO to 3699 20/ 3692-96 B/ 25 go 1 hr.

frac Comp. 40 bopd 40 bw