
KANSAS
FORM 51 5M 1-42 PETROL

Greenwood

Section 25 Township 27 Range 8E

Well No. #4 Temple

Company K.T. Wiedemann

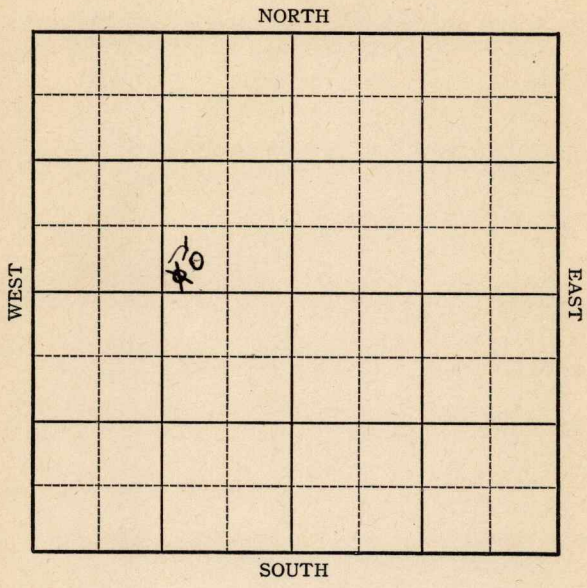

FORM 252-A
5M 9-42 GASS

Greenwood KANSAS

Sec. 25 Twp. 27 R. 8E

Well No. #4 Temple Farm

K. T. Wiedemann Company


(Miscellaneous)

Ft. from N. Line

330 Ft. from S. Line

990 Ft. from E. Line

Ft. from W. Line

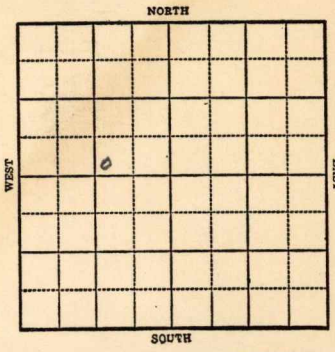

1942	REPORT
11/4	Machine
11/11	Rigging up
11/18	Drlg. 675
11/24	SD
12/2	12" @ 774, 10" @ 1171 Drlg. 1455
12/9	8" @ 1620 peru 1825 SSO 1837-40 Drlg. 2345
12/16	KC 1661 Miss 2423 TD 2451 7" @ 2424 HR 7"
12/22	Miss. 2423 7" @ 2437' T.D. 2452' 2000 gals. acid Pump 25 pot. Gravity 36

COMPLETED

Form 26 200 Blks 5-42 Petrol

KANSAS Greenwood

Map No. 10 Sec. 25 Twp. 27 R. 8E


Well No. 4 Temple

K. T. Wiedemann Company

FIRST REPORT Contractor

SW SE NW

SECTION PLAT

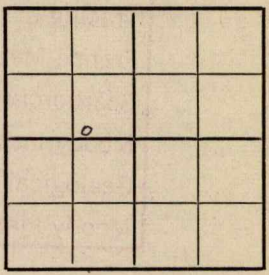

Ft. from N. Line

330 Ft. from S. Line

990 Ft. from E. Line

Ft. from W. Line

MISCELLANEOUS

Location

Rig up

Drilling and Remarks:

Machine

RECORD

Cased in., ft.

Sand

Gas

Oil

Total Depth

PRODUCTION

1st 24 hrs. Nat.

1st 24 hrs. after shot

Gas Cu. Ft.

Dry Hole

Abandoned

Date

NOV 4 1942 19 S. J. LEWIS Scout

Form 26 200 Bks 5-42 Petrol

Greenwood

KANSAS

Map No. 10 Sec. 25 Twp. 27 R. 8E


Well No. 4 Temple

K. T. Wiedemann Company

COMPLETED Contractor

SW SE NW

SECTION PLAT

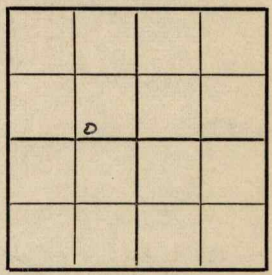

____ Ft. from N. Line

330 Ft. from S. Line

990 Ft. from E. Line

____ Ft. from W. Line

MISCELLANEOUS

Location

Rig up

Drilling and Remarks:

Wis 2423
7" @ 2437
2000 Gal
Pump .25 Bbl
36° Gr

RECORD

Cased ____ in., ____ ft.

Sand

Gas

Oil

Total Depth 2452

PRODUCTION

1st 24 hrs. Nat.

1st 24 hrs. after shot

Gas ____ Cu. Ft.

Dry Hole

Abandoned

Date

DEC 22 1942 19

S. J. LEWIS Scout