


Section 17 Township 32 Range 2E

Well No. 1 Hartsell (*Hartzell*)

Company Dunn & Strait Misc.

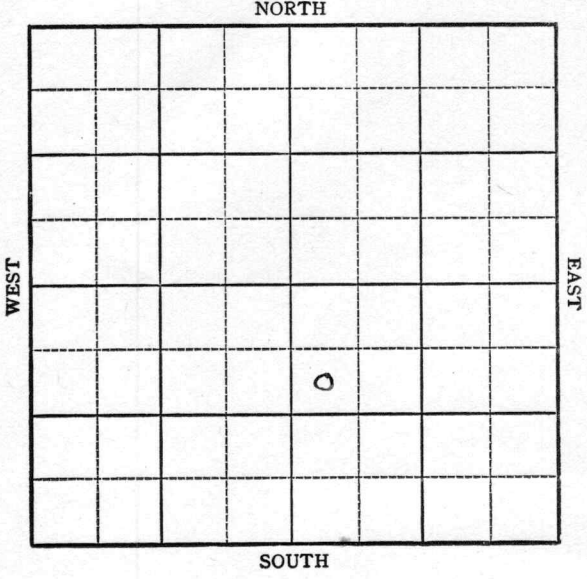

Sec. 17 Twp. 32 R. 2-E ✓

Well No. #1 Hartsell Farm  
Dunn & Strait Company  
Summer


990 Ft. from N. Line

\_\_\_\_\_ Ft. from S. Line

\_\_\_\_\_ Ft. from E. Line

330 Ft. from W. Line

SW NW SE

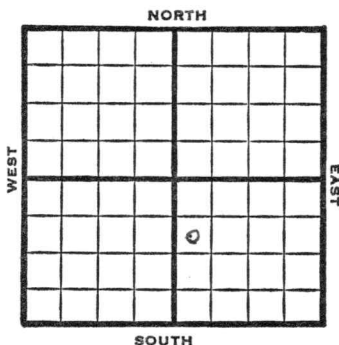

REPORT	
1948	Eli 1239'
10/6	Location
10/13	10" @ 60'
10/19	Drlg. 1983' KC 2783 Drlg. 3020'
10/26	Simpson 3648' TD 3652' 5" @ 3645'
11/3	"
11/10	"
11/16	"
11/23	"
11/30	TD 3685' 10 qts to CO
12/6	"
12/15	TD 3685' Simp 3648' 5" @ 3645' Pump 35 oil Pot 42° Gr. Comp <b>COMPLETED</b>

Map No. \_\_\_\_\_ Sec. 17 Twp. 32 R. 2E

Well No. 1 Hartsell

Dunn & Strait Company

FIRST REPORT Contractor

SW NW SE

SECTION PLAT

990 Ft. from N. Line

\_\_\_\_\_ Ft. from S. Line

\_\_\_\_\_ Ft. from E. Line

330 Ft. from W. Line


Sumner County

Location X

Rig up \_\_\_\_\_

Drilling and Remarks:

RECORD

Cased \_\_\_\_\_ in., \_\_\_\_\_ ft.

Sand \_\_\_\_\_

Gas \_\_\_\_\_

Oil \_\_\_\_\_

Total Depth \_\_\_\_\_

PRODUCTION

1st 24 hrs. Nat. \_\_\_\_\_

1st 24 hrs. after shot \_\_\_\_\_

Gas \_\_\_\_\_ Cu. Ft.

Dry Hole \_\_\_\_\_

Abandoned \_\_\_\_\_

Date

OCT 6 1948

19

S. J. LEWIS

Scout

Map No.        Sec. 17 Twp. 32 R. 2E

Well No. 1 Hartsell

Dunn & Strait Company

COMPLETE Contractor

SW NW SE

*E 11239*

SECTION PLAT

990 Ft. from N. Line

       Ft. from S. Line

       Ft. from E. Line

330 Ft. from W. Line

		6	

Sumner County

Location       

Rig up       

Drilling and Remarks:

*Aug. 31 48*  
*51108675*  
*Prod 85 oil*

*42 e m*

RECORD

Cased        in.,        ft.

Sand       

Gas       

Oil       

Total Depth 3685

PRODUCTION

1st 24 hrs. Nat.       

1st 24 hrs. after shot       

Gas        Cu. Ft.

Dry Hole       

Abandoned       

Date

DEC 15 1948 19

S. J. LEWIS Scout