


Map No. Sec. 17 Twp. 32 R. 2E

Well No. 1 Hartzell Farm
Twin States Oil Company

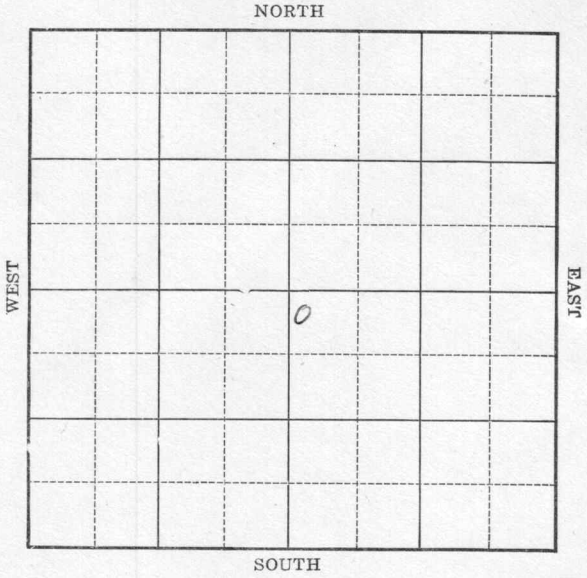

Location _____

Drilling Remarks _____

Rig Up _____

Drilling Remarks _____

RECORD

Cased _____ in. _____ ft.

Sand _____

Gas _____

Oil _____

Total Depth _____

PRODUCTION

1st 24 hrs. Nat. _____

1st 24 hrs. after shot _____

Gas _____ cu. ft.

Dry Hole _____

Abandoned _____

Map No. Kansas Sec. 17 Twp. 32 R. 2E

Well No. 1 Hartzell Farm


Twin States Oil Company

300 Ft. from N. Line

..... Ft. from S. Line

..... Ft. from E. Line

300 Ft. from W. Line

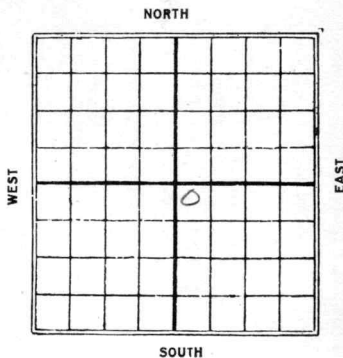

Date

REPORT

1926	
6/16	R.O.G.
6/23	Rig building
6/30	Spud
7/14	Dlg 1105
7/22	" 1345
8/11	Str reaming 8" 2380-T.D.
8/18	Dlg 2510
8/25	" 3015
8/31	T.D. 3280 S.D. to get
	some titles
9/1	top line 3330 - Dlg 3370
9/8	3330 Top line fsg at 3420
9/15	---
9/22	Top Wilcox 3657
	Drly 3639
9/29	oil in siliceous line
	3705 - 3715; 705 bbls
	1st 16 hrs.; 5-40 2nd 16 hrs
	715 next 18 hrs.
	swab & flow
10/6	Wilcox 3669-3685
S.L.M.	Sil. Line 3705 - 3713 1/2
	swabbed 765 bbls

K *Samuel*
Map No. **KANSAS** Sec. *17* Twp. *32* R. *2E*

Well No. *1 Hartzell*

Twin States Oil Company

Contractor

SECTION PLAT

		0	

300 Ft. from N. Line

----- Ft. from S. Line

----- Ft. from E. Line

300 Ft. from W. Line

FIRST REPORTS

Location -----

Rig up -----

Drilling and Remarks:

ROG

RECORD

Cased ----- in., ----- ft.

Sand -----

Gas -----

Oil -----

Total Depth -----

PRODUCTION

1st 24 hrs. Nat. -----

1st 24 hrs. after shot -----

Gas ----- Cu. Ft.

Dry Hole -----

Abandoned -----

Date

JUN 16 1926

192

S. J. LEWIS

Scout

Map No. **KANSAS** Sec. 17 Twp. 32 R. 2E

Well No. 1 Hartzell

Twin States Oil Company

Contractor

SECTION PLAT

800 Ft. from N. Line

----- Ft. from S. Line

----- Ft. from E. Line

300 Ft. from W. Line

		0	

COMPLETED

Location -----

Rig up -----

Drilling and Remarks:

Helco 3669 & 3685

Sil line 23705 oil

& 3713 1/2 T.D.S.H

M.

Swabbed 765

yx ls.

RECORD

Cased ----- in., ----- ft.

Sand -----

Gas -----

Oil -----

Total Depth -----

PRODUCTION

1st 24 hrs. Nat. -----

1st 24 hrs. after shot -----

Gas ----- Cu. Ft.

Dry Hole -----

Abandoned -----

Date

OCT 6 1926

S. J. LEWIS

Scout