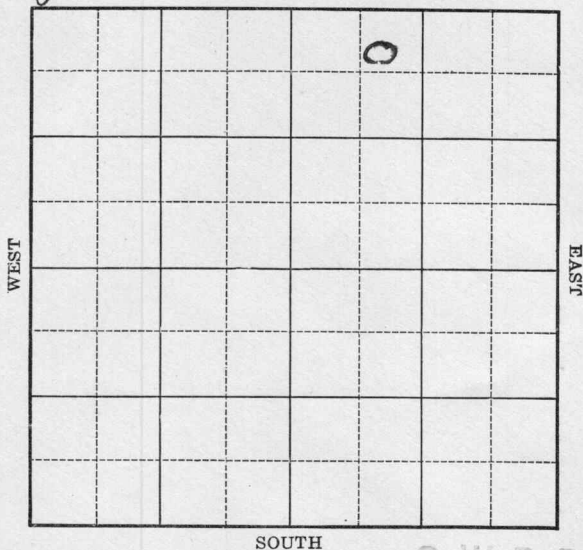


Map No. _____ Sec 14 Twp. 32 R. 2E
 Well No. 1-Townsite Farm _____
Roy Ramsey et al Company _____
 NORTH



Location _____

Drilling Remarks _____

Rig Up _____

Drilling Remarks _____

RECORD

Cased _____ in. _____ ft.

Sand _____

Gas _____

Oil _____

Total Depth _____

PRODUCTION

1st 24 hrs. Nat. _____

1st 24 hrs. after shot _____

Gas _____ cu. ft.

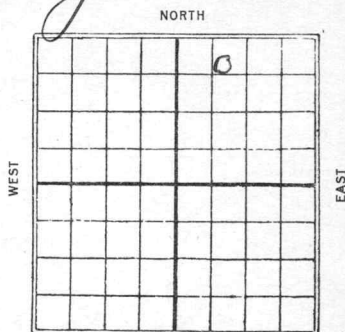
Dry Hole _____

Abandoned _____

Map No. _____ Sec. 14 Twp. 32 R. 2EWell No. 1-Townsite Farm _____Roy Ramsey et al Company450 Ft. from N. Line

_____ Ft. from S. Line

_____ Ft. from E. Line

835 Ft. from W. Line1927 Lot 1 - Block 87. ^{SOUTH} Oxford Tste

Date

REPORT

O. W. D. D

7/13 Rig
7/20 Spud
7/27 Drlg 400
8/3 " 675
8/10 " 1140
8/17 sand 1665 show oil & Gas
1667-H.F.W. Drlg 1704 in
sand
8/24 Top Ad. 1845-Drlg 1849-flow
65 bbls oil 5 hrs.
8/31 Top Ad 2018-T.D. 2117-Swabbed
595 bbls in 24 hrs.
9/7 T.S. 2018 T.D. 2117
595 bbls 24 hrs. nat.
90/2097-2116
450 bbls 24 hrs.
flowing
1935
11/27 Rep Rig
12/6 Rgn Sp.
12/13 WR 8" 1916

OVER

12/19 2165 log 8" pipe

12/26 —

1/2/36 log 2435

1/10 6" 2580

Top Dolo 2880

TD 2882

2500' Oil

Set 326' of 5 7/16 liner

log deeper

1/17 TD 2899

Swabbed 165 Oil 2 hrs

1/24 TD 2972 3000 acid

Made 430 Oil 12 hrs.

1/29 Dolomite 2880

TD 2972

3000 acid

8000 "

1312 Bbls.

COMPLETED

Map No. KANSAS Sec. 14 Twp. 32 R. 2E

Well No. 1 Townsite

Roy Ramsey & Co Company

Oxford Townsite Contractor

Lot 1 Block 87

SECTION PLAT

		0	

450 Ft. from N. Line

----- Ft. from S. Line

----- Ft. from E. Line

835 Ft. from W. Line

FIRST REPORTS

Location -----

Rig up -----

Drilling and Remarks:

Rig
This is on a strip
20' x 165' East of
Lot 12 Block 87
or 119' West of
M.V. RR right of way

RECORD

Cased ----- in., ----- ft.

Sand -----

Gas -----

Oil -----

Total Depth -----

PRODUCTION

1st 24 hrs. Nat. -----

1st 24 hrs. after shot -----

Gas ----- Cu. Ft.

Dry Hole -----

Abandoned -----

Date

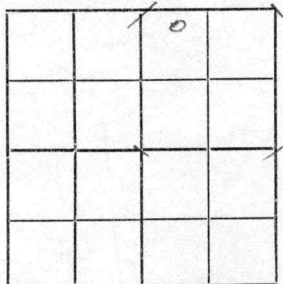
JUL 13 1927

S. J. LEWIS

Scout

Map No. KANSAS Sec. 14 Twp. 32 R. 2EWell No. La 81 Block 87Roy Ramsey & Co. CompanyOpical Concrete Contractor

SECTION PLAT

450 Ft. from N. Line

----- Ft. from S. Line

----- Ft. from E. Line

835 Ft. from W. Line**COMPLETED**

Location -----

Rig up -----

Drilling and Remarks:

T.D. 2018T.D. 2117595 x 8 1/2 24 hrs Nat90/2097-2116450 x 8 1/2 24 hrsFlowing

RECORD

Cased ----- in., ----- ft.

Sand -----

Gas -----

Oil -----

Total Depth -----

PRODUCTION

1st 24 hrs. Nat. -----

1st 24 hrs. after shot -----

Gas ----- Cu. Ft.

Dry Hole -----

Abandoned -----

Date

SEP 7 1927

S. J. LEWIS

Scout

192

Map No. 1 Sec. 14 Twp. 32 R. 2EWell No. 1 - TownlotRamsey pet Company

Contractor

FIRST REPORTS

SECTION PLAT

		0	

450 Ft. from N. Line

Ft. from S. Line

Ft. from E. Line

835 Ft. from W. LineOWDD

Location

Rig up

Drilling and Remarks:

OTD 2116Rep. RigWe do not have
record of old
well.

RECORD

Cased.....in.,ft.

Sand.....

Gas.....

Oil.....

Total Depth.....

PRODUCTION

1st 24 hrs. Nat.....

1st 24 hrs. after shot.....

Gas.....Cu. Ft.

Dry Hole.....

Abandoned.....

Date

192

ORVAL MANNSCHRECK

Scout

Map No. 1 Sec. 14 Twp. 32 R. 2 EWell No. 1-TownlotRamsey Company

Contractor

COMPLETE

SECTION PLAT

450 Ft. from N. Line

Ft. from S. Line

Ft. from E. Line

835 Ft. from W. LineOwad

Location

Rig up

Drilling and Remarks:

3000 acid
8000 acid1312 bbls

RECORD

Cased in. ft.Sand Dolomite 2880

Gas

Oil

Total Depth 2972

PRODUCTION

1st 24 hrs. Nat.

1st 24 hrs. after shot

Gas Cu. Ft.

Dry Hole

Abandoned

Date

ORVAL MANNSCHRECK

1-29-36 192

Scout